

WAYNE
 ✓ 2018
 4-21-79

MISSISSIPPI
 BOARD OF WATER COMMISSIONERS
 416 North State Street
 Jackson, Mississippi 39201

WATER WELL DRILLERS LOG

April 24 1979 *Porter Drilling* *Wayne*
 date well completed firm name county well located

LANDOWNER: *Alton Gray*
Al 1 Box 103
State Line Miss
 (mailing address)

WELL LOCATION:
 sec. *32* T. *6* N. R. *6* E
8 miles *SW* of *Quikturn*
 (distance) (direction) (nearest town)

WELL PURPOSE: *Home*
 (home, irrigation, municipal, industrial)

WELL COMPLETION DATA:

- (1) diameter (inches) *2"*
 - (2) total depth (feet) *510'*
 - (3) static water level (feet) *136'* ^{below} top of ground
 - (4) casing *P.V.C. 50.5'*
 (material) (depth)
2"
 (size) If telescope see back.
 - (5) screen *5'* *50.5'*
 (length) (depth to top)
2" *cast S.S.*
 (size) (material)
 - (6) pump *2* *5*
 (HP) (yield gpm)
elec.
 (type power)
 - (7) electric log *no*
 (yes or no)
- (organization running log)
- (8) how well bottom plugged
2" backwash valve


description of formations encountered	from	to
<i>Clay</i>	<i>0</i>	<i>92</i>
<i>sand & clay</i>	<i>92</i>	<i>110</i>
<i>Clay</i>	<i>110</i>	<i>174</i>
<i>fine sand</i>	<i>174</i>	<i>178</i>
<i>Clay</i>	<i>178</i>	<i>198</i>
<i>Clay & fine sand</i>	<i>198</i>	<i>207</i>
<i>fine yellow sand</i>	<i>207</i>	<i>234</i>
<i>harder clay</i>	<i>234</i>	<i>258</i>
<i>Clay &</i>	<i>258</i>	<i>267</i>
<i>sa. & clay</i>	<i>267</i>	<i>280</i>
<i>fine sand & sand</i>	<i>280</i>	<i>318</i>
<i>Clay</i>	<i>318</i>	<i>350</i>
<i>finer sand</i>	<i>350</i>	<i>365</i>
<i>Clay</i>	<i>365</i>	<i>425</i>
<i>sand & some clay</i>	<i>425</i>	<i>492</i>
<i>med fine clean sand</i>	<i>492</i>	<i>500</i>
<i>Clay med coarse sand</i>	<i>500</i>	<i>510</i>
<i>fine sand</i>	<i>510</i>	<i>513</i>
<i>light med soft sand</i>		
<i>blue impure clay</i>		
<i>147' 1 1/2" galv steel</i>		
<i>long pipe</i>		

DRILLERS REMARKS:

Miss. Board of Water Com. *RECEIVED*
 MAY 18 1979

If well telescopes please sketch and show depths.

GROUND LEVEL

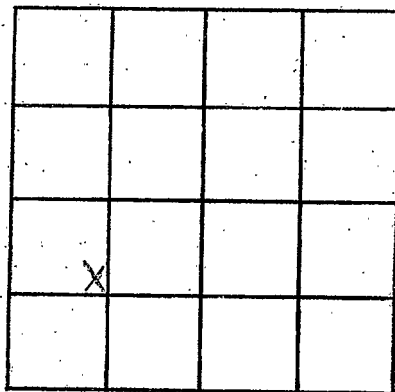

SECTION 32

Please indicate well location X.

ADDITIONAL INFORMATION

If more than one screen, show locations of each on sketch.