

WAYNE
 Y 2009
 2-12-79

MISSISSIPPI
 BOARD OF WATER COMMISSIONERS
 416 North State Street
 Jackson, Mississippi 39201

WATER WELL DRILLERS LOG

Feb 2, 1979 *Proctor Drilling* *Wayne*
 date well completed firm name county well located

LANDOWNER: *James McLean* description of formations encountered from to
RT1
State Line Miss
 (mailing address)

WELL LOCATION:
 sec *20* T *6* N R *6* E
5 miles SW of *Beaumont*
 (distance) (direction) (nearest town)

WELL PURPOSE: *Home*
 (home, irrigation, municipal, industrial)

- WELL COMPLETION DATA:
- (1) diameter (inches) *2"*
 - (2) total depth (feet) *316*
 - (3) static water level (feet) *28* below above
 top of ground.
 - (4) casing *PVC* *311'*
 (material) (depth)
2 If telescope see back.
 (size)
 - (5) screen *5'* *311'*
 (length) (depth to top)
2" *60lb SS*
 (size) (material)
 - (6) pump *1* *15*
 (HP) (yield gpm)
cler
 (type power)
 - (7) electric log *no*
 (yes or no)

description of formations encountered	from	to
<i>clay</i>	<i>0</i>	<i>126</i>
<i>sand & clay</i>	<i>126</i>	<i>132</i>
<i>clay</i>	<i>132</i>	<i>162</i>
<i>sand fine sand</i>	<i>162</i>	<i>193</i>
<i>sand buff sand</i>	<i>193</i>	<i>210</i>
<i>clay & sand</i>	<i>210</i>	<i>228</i>
<i>clay & sand</i>	<i>228</i>	<i>243</i>
<i>clay</i>	<i>243</i>	<i>277</i>
<i>fine sand</i>	<i>277</i>	<i>288</i>
<i>clay</i>	<i>288</i>	<i>294</i>
<i>thin fine course sand</i>	<i>294</i>	<i>317</i>
<i>buff course sand</i>	<i>317</i>	<i>316</i>
<i>stagnant dolomite</i>		
<i>little still in sand</i>		

42' 1" PVC drop pipe

(organization running log)

Miss. Board of Water Comm.

(8) how well bottom plugged *2" back wash valve*


FEB 8 1979

DRILLERS REMARKS:

RECEIVED

If well telescopes please sketch and show depths.

GROUND LEVEL

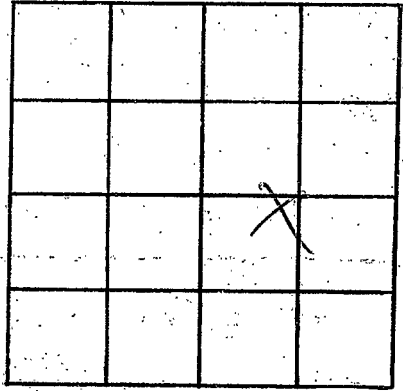

SECTION 20

Please indicate well location X.

ADDITIONAL INFORMATION

If more than one screen,
show locations of each on sketch.