

Wayne
 Y 2020
 8-23-79

MISSISSIPPI
 BOARD OF WATER COMMISSIONERS
 416 North State Street
 Jackson, Mississippi 39201

WATER WELL DRILLERS LOG

Aug 23 19 79 Porter Drilling Itasca
 date well completed firm name county well located

LANDOWNER: Terry Kallay
Box 1 State Line, Miss

description of formations encountered	from	to
sand	0	14
clay	14	111
sand & clay	111	119
sand	119	120
clay	120	128
sand	128	139
clay	139	142
sand	142	148
clay	148	153
sand	153	210
clay	210	266
clay some sand	266	280
fine sand	280	336
fine sand, clay	336	378
clay	378	389
fine sand sand	389	423
clay	423	450
sand & clay	450	470
fine med sand	470	495
artesian sand		

(mailing address)

WELL LOCATION:
 sec. 32 T. 6 N. R. 6 E.
8 miles SW of Frankston
 (distance) (direction) (nearest town)

WELL PURPOSE: home
 (home, irrigation, municipal, industrial)

WELL COMPLETION DATA:
 (1) diameter (inches) 2"
 (2) total depth (feet) 495'
 (3) static water level (feet) 135' (below/above top of ground.)
 (4) casing PVC, 490' (material) (depth)
2" if telescope see back. (size)
 (5) screen 5', 490' (length) (depth to top)
2", 6 sht. S.S. (size) (material)
 (6) pump 2 (HP) 6 (yield gpm)
elec (type power)
 (7) electric log no (yes or no)
 (organization running log)

(8) how well bottom plugged
2" sand shell

DRILLERS REMARKS:
shell trap

description of formations encountered	from	to
sand	0	14
clay	14	111
sand & clay	111	119
sand	119	120
clay	120	128
sand	128	139
clay	139	142
sand	142	148
clay	148	153
sand	153	210
clay	210	266
clay some sand	266	280
fine sand	280	336
fine sand, clay	336	378
clay	378	389
fine sand sand	389	423
clay	423	450
sand & clay	450	470
fine med sand	470	495
artesian sand		

147' 1 1/4" galv. drop pipe


Miss. Board of Water Comm.

SEP 10 1979

RECEIVED

If well telescopes please sketch and show depths.

GROUND LEVEL

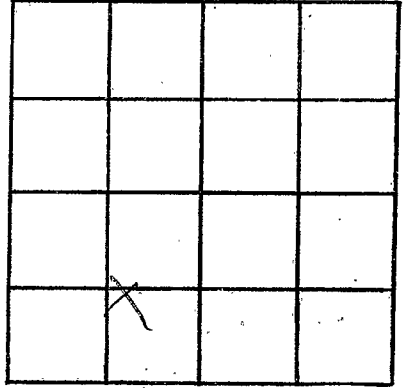

SECTION 32

Please indicate well location X.

ADDITIONAL INFORMATION

If more than one screen,
show locations of each on sketch.