

MISSISSIPPI DEPARTMENT OF NATURAL RESOURCES

Bureau of Land and Water Resources

Southport Mall

P.O. Box 10631

Jackson, Mississippi 39209

WATER WELL DRILLERS LOG

WAYNE

Y 2021

5-22-81

May 22 1981

Porter Drilling & Log

Wayne

date well completed

firm name

county well located

LANDOWNER:

Claude
Earl Kelley

description of formations
encountered

from

to

At 1 State Line Miss.
(mailing address)

clay & sand	0	20
clay	20	203
fine & hard sand	203	235
med soft sand & clay	235	255
clay	255	265
fine & hard sand	265	318
clay & some sand	318	330
sand	330	362
sand & clay	362	366
clay	366	372
fine sand	372	393
clay	393	435
med fine hard sand	435	450
clay	450	452
clay	452	492
hard sand	492	507
stopped on clay		

WELL LOCATION:

sec 32 T 6 N R 6 E
8 miles SW Buckatunna
(distance) (direction) (nearest town)

WELL PURPOSE: home
(home, irrigation, municipal, industrial)

WELL COMPLETION DATA:

- (1) diameter (inches) 2"
- (2) total depth (feet) 507'
- (3) static water level (feet) 140' (below top of ground)
- (4) casing P.V.C. 502'
(material) (depth)
- (5) screen 2" 502'
(size) (length) (depth to top)
- 2" block S.S.
(size) (material)
- (6) pump 2 5
(HP) (yield gpm)
- elec.
(type power)
- (7) electric log no
(yes or no)

(organization running log)


(8) how well bottom plugged
2" back wash valve

DRILLERS REMARKS:



If well telescopes please sketch and show depths.

GROUND LEVEL

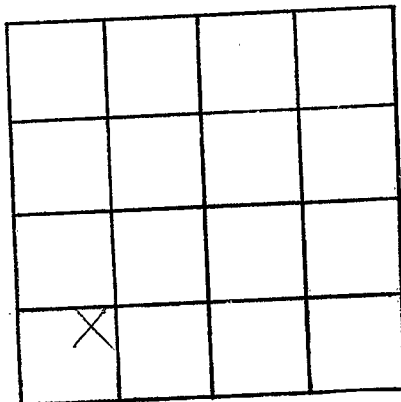

SECTION 32

Please indicate well location X.

ADDITIONAL INFORMATION

If more than one screen, show locations of each on sketch.