

MISSISSIPPI DEPARTMENT OF NATURAL RESOURCES

Bureau of Land and Water Resources

Southport Mall

P.O. Box 10631

Jackson, Mississippi 39209

WATER WELL DRILLERS LOG

Wayne  
4  
2023

March 2 1982 date well completed  
Barto Drilling Co. firm name  
Wayne county well located

LANDOWNER: Neal E. Goff  
P.O. 1 Buckatanna  
Miss.  
(mailing address)

WELL LOCATION:  
sec. 3 T. 6 N. R. 6 E.  
1 1/2 miles SW of Buckatanna  
(distance) (direction) (nearest town)

WELL PURPOSE: Home  
(home, irrigation, municipal, industrial)

- WELL COMPLETION DATA:
- (1) diameter (inches) 2"
  - (2) total depth (feet) 172'
  - (3) static water level (feet) 99' (below/above top of ground)
  - (4) casing PVC, 168' (material), (depth)  
2" (size) If telescope see back.
  - (5) screen 5', 168' (length), (depth to top)  
2" (size), galv. S.S. (material)
  - (6) pump 1 1/2, 6 (HP), (yield gpm)  
elec (type power)
  - (7) electric log no (yes or no)  
(organization running log)
  - (8) how well bottom plugged  
2" sand slush

description of formations encountered	from	to
sand & clay	0	20
clay	20	50
sand & clay	50	56
sand	56	60
clay some sand	60	64
rocks		64
clay some sand	64	162
med. clean sand	162	173
120' 1 1/4" # 80 dry pipe		

DEPT. OF NATURAL RESOURCES  
BUREAU OF LAND & WATER


APR 20 1982

RECEIVED

DRILLERS REMARKS:

If well telescopes please sketch and show depths.

GROUND LEVEL

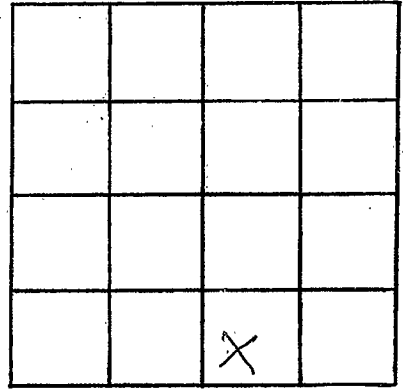

SECTION 3

Please indicate well location X.

ADDITIONAL INFORMATION

If more than one screen,  
show locations of each on sketch.