

MISSISSIPPI DEPARTMENT OF NATURAL RESOURCES

Bureau of Land and Water Resources

Southport Mall

P.O. Box 10631

Jackson, Mississippi 39209

WATER WELL DRILLERS LOG

L

Wayne
Y. 2026
5-17-85

May 17 1985 date well completed      Pro. Drilling & Log. firm name      Wayne county well located

LANDOWNER: David Mills  
 Rt 1 Box 293  
 State Line Ms.  
 (mailing address)

description of formations encountered	from	to
	sand	0

WELL LOCATION:  
 sec. 34 T. 6 N. R. 6 E.  
 7 miles S of Buckatunna  
 (distance) (direction) (nearest town)

30' 1" PVC deep pump

WELL PURPOSE: home  
 (home, irrigation, municipal, industrial)

WELL COMPLETION DATA:

(1) diameter (inches) 2'

(2) total depth (feet) 36'

(3) static water level (feet) 9' below top of ground.

(4) casing PVC, 31' (material) (depth)  
 2' (size) if telescope see back.

(5) screen 5' (length), 31' (depth to top)  
 2" (size), bobt S.S. (material)

(6) pump 1 (HP), 6 (yield gpm)  
 elec. (type power)

(7) electric log no (yes or no)  
 (organization running log)

(8) how well bottom plugged  
 2' sand which was not deep

RECEIVED


JUL 28 1985

Department of Natural Resources  
 Bureau of Land & Water Resources

DRILLERS REMARKS:

If well telescopes please sketch and show depths.

GROUND LEVEL

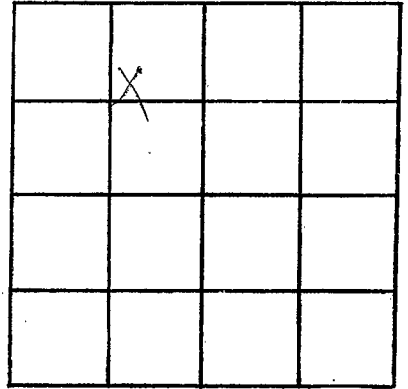

SECTION 34

Please indicate well location X.

ADDITIONAL INFORMATION

If more than one screen, show locations of each on sketch.