

MISSISSIPPI DEPARTMENT OF NATURAL RESOURCES

Bureau of Land and Water Resources

Southport Mall

P.O. Box 10631

Jackson, Mississippi 39209

WATER WELL DRILLERS LOG

Wayne  
4 20027

12-12-87

Griner Drilling Service, Inc.

Wayne

date well completed

firm name

county well located

LANDOWNER:

Tesoro Petroleum Corporation  
P.O. Box 2909  
Laurel, Ms. 39442  
(mailing address)

description of formations encountered

from

to

clay, small sand breaks 0 200

WELL LOCATION: 753' N 4 682' E

sand 200 270

sec 29 T 6 N R 6 E of

clay, sand streaks 270 375

Zinn Petroleum Chicoro  
No. 1 Staff Paper Co.  
(direction of nearest town)

sand 375 460

WELL PURPOSE:

(home, irrigation, municipal, industrial)

rock 460 462

WELL COMPLETION DATA:

(1) diameter (inches) 3"

(2) total depth (feet) 462'

(3) static water level (feet) 50' below top of ground.

(4) casing steel 462' (material) (depth)

3" (size) if telescope see back.

(5) screen 462' 420' (length) (depth to top)

3" perforated (size) (material)

(6) pump AC 80 (HP) (yield gpm)

AC (type power)

(7) electric log (yes or no)

(organization running log)

(8) how well bottom plugged peel orange

DRILLERS REMARKS:


RECEIVED

JAN 14 1987

Department of Natural Resources  
Bureau of Land & Water Resources

If well telescopes please sketch and show depths.

GROUND LEVEL

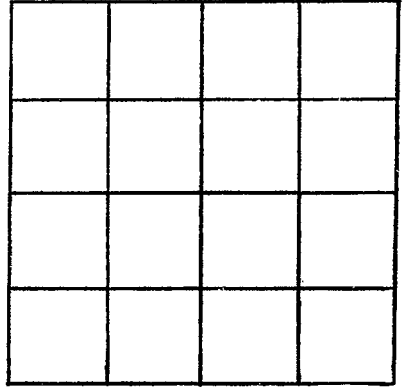

SECTION \_\_\_\_\_

Please indicate well location X.

ADDITIONAL INFORMATION

If more than one screen,  
show locations of each on sketch.