

MISSISSIPPI DEPARTMENT OF ENVIRONMENTAL QUALITY

Office of Land and Water Resources

P. O. Box 10631
Jackson, MS 39289-0631
WATER WELL DRILLERS LOG

COUNTY WELL LOCATED
WAYNE

WELL NUMBER **Y2031** CODED

DATE WELL COMPLETED
5/16/99

PERMIT NUMBER
0-624

NAME OF DRILLING FIRM
THOMPSON BROS.

NAME & MAILING ADDRESS OF LANDOWNER
GREG REVETTE
P.O. BOX 203
BUCKATUNNA MS, 39322

WELL LOCATION: SEC **25** TOWNSHIP **7** RANGE **6**

DISTANCE **1** Miles **N** of **BUCKATUNNA**

OTHER LANDMARK

WELL PURPOSE: Home, Irrigation, Municipal, Industrial, Fish Pond, etc.

PUMP DATA

PUMP TYPE (Circle One):
Submersible, Turbine, Jet, Flowing Well,
Other (Describe) _____

POWER TYPE (Circle One):
Electric, Tractor, Diesel, Gasoline, Butane,
Other (Describe) _____ H/P _____

Pump Capacity (GPM) **19** No. of Stages _____ Setting Depth **60** FT.

PUMP TEST

Well yielded **40** GPM with
a drawdown of **50** ft.
AIR LIFT
after _____ hours of pumping

WELL DATA

Well Depth 122	Casing Diameter (In.) 4"	Casing Length (Ft.) 112
Type of Casing PVC	Hole Depth 122	Depth to Static Water Level. 18'

LOG DATA

TYPE OF LOG RUN (Circle One): _____ No Log Run,
Electric, Gamma-Ray, Density, Sonic, Neutron,
Other (Describe) _____

Name of Organization Running Log.

TYPE OF COMPLETION: (Circle One or More):
Natural Development, Gravel Packed, Underreamed, Telescoped,
Open Hole, Other

WELL GROUTED TO A DEPTH OF **10** FEET
Type Grout (circle one): Cement, Bentonite, or Mix

GEOLOGIC DATA (Office Use Only)


Surface Elev.	Geologic Unit	Unit Thickness	Depth to Top
Subs. SWL	Date	Analysis	Aquifer Test

SCREEN DATA

Diameter - Inches 4	Length - Feet 10	Slot Size - Inches .010
Screen Type PVC SLOTTED	Depth to Bottom - Feet 122	


Driller's Remarks

DESCRIPTION OF FORMATIONS ENCOUNTERED	FROM	TO
RED CLAY	0	15
SAND	15	50
HARD CLAY	50	84
SAND	84	122

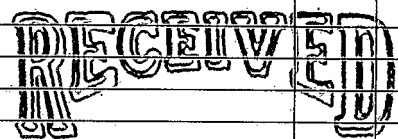FORMATIONS (Continued)	FROM	TO
 JUL 22 1999		
Dept of Environmental Quality Office of Land & Water Resources		

If well telescopes please sketch and show depths.

GROUND LEVEL

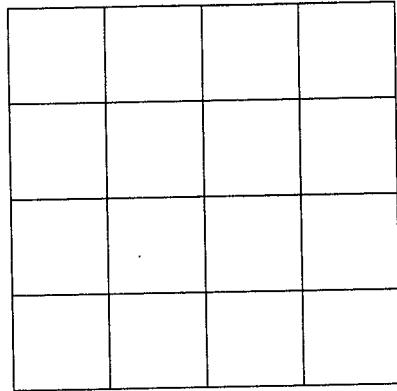

SECTION _____

Please indicate well location X.

ADDITIONAL INFORMATION

If more than one screen, show location of each on sketch.