

NO S.T.R.

Wayne
Z
7-23-80

MISSISSIPPI
BOARD OF WATER COMMISSIONERS
416 North State Street
Jackson, Mississippi 39201

WATER WELL DRILLERS LOG

7-23-1980 date well completed
Furber Well Services firm name
Wayne county well located

LANDOWNER: ADA Brewer
Rt. 2, Box 17
Wuedale, ms
(mailing address)

WELL LOCATION: State line
sec. — T — N R — E
S W
miles of State line
(distance) (direction) (nearest town)

WELL PURPOSE:
(home, irrigation, municipal, industrial)

WELL COMPLETION DATA: 7-23-80

- (1) diameter (inches) 2"
- (2) total depth (feet) 240'
- (3) static water level (feet) 80' ^{below}/_{above} top of ground.
- (4) casing Pvc 230'
(material) (depth)

(size) if telescope see back.
- (5) screen 10' 230'
(length) (depth to top)
2" Pvc
(size) (material)
- (6) pump 1 5
(HP) (yield gpm)
E/E
(type power)
- (7) electric log (yes or no)

(organization running log)

(8) how well bottom plugged 2" Pvc
Backwash Valve

DRILLERS REMARKS:

description of formations encountered	from	to
Top Soil	0	10
Clay	10	50
fine Sand	50	70
Clay	70	100
Clay	100	150
med Sand	150	160
Blue Clay	160	200
Clay	200	240
fine Sand	240	250
med Sand	250	260


DEPT. OF NATURAL RESOURCES
BUREAU OF LAND & WATER RESOURCES

AUG 15 1980

RECEIVED

If well telescopes please sketch and show depths.

GROUND LEVEL

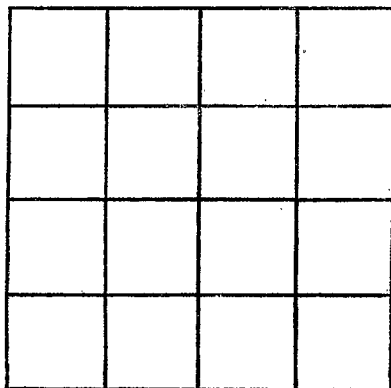

SECTION _____

Please indicate well location X.

ADDITIONAL INFORMATION

If more than one screen,
show locations of each on sketch.