

Z7

4-23-64

WATER WELL DRILLERS LOG

Date: April 23 1964, Driller: Porter Drilling & Log County Wayne
 (Name)

(1) Owner of Land: J. J. Becton
 (Name)
At 2 State Line
 (Address)

(2) Location: MW 1/4, SE 1/4, Sec. 8 T6 R5
4 miles south of Buckatun
 (distance) (direction) (Nearest Town)

(3) Topography: flat
 (Hilly) (Flat) (Level)

(4) Purpose of Well: domestic
 (Domestic Irrigation
 Municipal, Industrial, Other)

Description & Color of Materials Sand, Clay, Red Clay, Shell, etc.	Thick- ness Feet	Depth Feet
<u>red clay</u>	<u>8</u>	<u>8</u>
<u>fine sand</u>	<u>32</u>	<u>40</u>
<u>sand & chalk</u>	<u>20</u>	<u>60</u>
<u>med. clean sand</u>	<u>7</u>	<u>67</u>
<u>stagnant white silty sand</u>		

Information upon completion of well:

(1) Diameter 2' inches.

(2) Total Depth 67 feet.

(3) Water Level 28' feet below top of ground.


(4) Cased to 63', Size 2"

(5) Screen: Size 1 1/4", Length 4'
Johnson S.S.

(6) Were any formations sealed against pollution?
no

If YES depth of formation _____
 Why _____

Drillers Remarks: _____

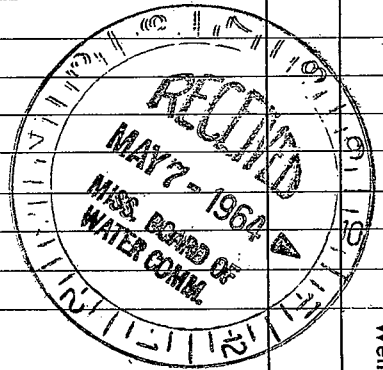

Well No.

(Use Back Side)

...the ...

...the ...

