

WAYNE

MISSISSIPPI BOARD OF WATER COMMISSIONERS

Z¹⁰

3-11-66

WATER WELL DRILLERS LOG

Date: March 11, 1966, Driller: Porter Drilling & Supply County: Wayne
(Name)

(1) Owner of Land: D. N. Pope
(Name)
At 2 State Line
(Address)

(2) Location: SW 1/4 SE 1/4, Sec. 3 T6 R5
4 miles S.E., of Buckatunna
(distance) (direction) (Nearest Town)

(3) Topography: Hilly
(Hilly) (Flat) (Level)

(4) Purpose of Well: domestic
(Domestic Irrigation
Municipal, Industrial, Other)

Description & Color of Materials Sand, Clay, Red Clay, Shell, etc.	Thick- ness Feet	Depth Feet
<u>red clay</u>	<u>8</u>	<u>8</u>
<u>mixed sand</u>	<u>22</u>	<u>30</u>
<u>clean sand</u>	<u>5</u>	<u>35</u>
<u>mixed sand</u>	<u>7</u>	<u>42</u>
<u>stop on chert</u>		

Information upon completion of well:

(1) Diameter 2" inches.

(2) Total Depth 36' feet.

(3) Water Level 8' feet below top of ground.

(4) Cased to 30', Size 2"


(5) Screen: Size 1 1/4, Length 6'
60 ga

(6) Were any formations sealed against pollution?
no

If YES depth of formation _____

Why _____

Drillers Remarks: _____

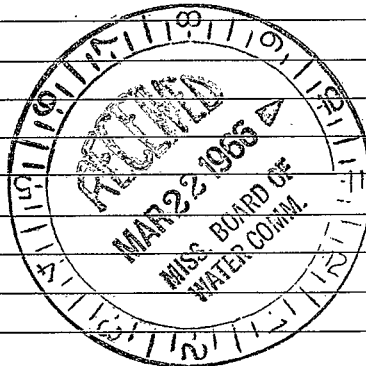

(Use Back Side)

Well No.

