

Z 11

2-25-63

WATER WELL DRILLERS LOG


Date: Feb 25, 1963, Driller: Porter Drilling & Exp. Co., Wayne County, Wayne

(1) Owner of Land: J. B. Collins
 (Name)
Lot 2 State Line, Miss
 (Address)
 (2) Location: NW 1/4, SW 1/4, Sec. 4 T6 R5,
3 miles SE of Buckatunna
 (distance) (direction) (Nearest Town)
 (3) Topography: Hilly
 (Hilly) (Flat) (Level)
 (4) Purpose of Well: domestic
 (Domestic Irrigation
 Municipal, Industrial, Other)

Description & Color of Materials Sand, Clay, Red Clay, Shell, etc.	Thick- ness Feet	Depth Feet
red clay & sand	35	35
red chab. & sand	5	40
dry med sand	23	63
white chab.	15	78
dry coarse sand	8	86
chab.	14	100
med sand	25	125
stopped while still in sand		

Information upon completion of well:

(1) Diameter 2" inches.
 (2) Total Depth 125' feet.
 (3) Water Level 103 feet below top of ground.
 (4) Cased to 111, Size 2"
 (5) Screen: Size 1 1/4, Length 6'
80 ga.
 (6) Were any formations sealed against pollution?
 _____ yes, X no.

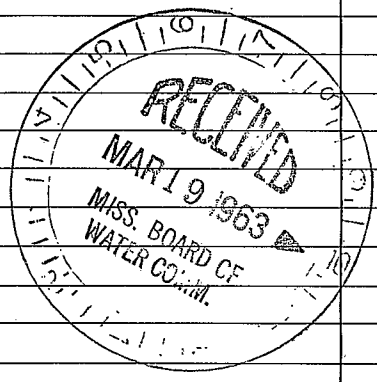

If YES depth of formation _____
 Why _____
 Drillers Remarks: _____

(Use Back Side)

Well No.

