

WAYNE

Date: Sept 21, 1962, Driller: Peepers & Rutledge County Wayne
(Name)

(1) Owner of Land: Robert Gordon
(Name)
State Line R.R. 2, Miss
(Address)

(2) Location: $\frac{1}{4}$, $\frac{1}{4}$, Sec. 8 T6R5,
3 1/2 miles S, of Buchanan
(distance) (direction) (Nearest Town)

(3) Topography: Hilly
(Hilly) (Flat) (Level)

(4) Purpose of Well: Chicken House
(Domestic Irrigation
Municipal, Industrial, Other)

Description & Color of Materials Sand, Clay, Red Clay, Shell, etc.	Thick- ness Feet	Depth Feet
<u>Top soil to yellow sand</u>		
<u>+ sandy clay streaks</u>	<u>42</u>	<u>42</u>
<u>yellow sand</u>	<u>27</u>	<u>69</u>

Information upon completion of well:

(1) Diameter 2 inches.

(2) Total Depth 69 feet.

(3) Water Level 33 feet below top of ground.

(4) Cased to 63', Size 2".


(5) Screen: Size 2", Length 6'.

(6) Were any formations sealed against pollution?
_____ yes, _____ no.

If YES depth of formation _____

Why _____

Drillers Remarks: _____

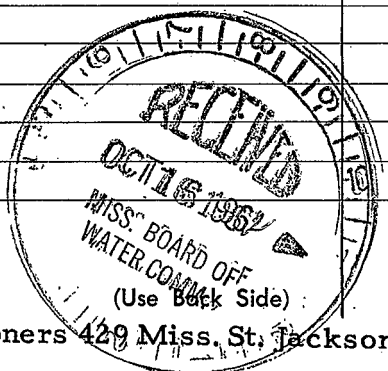

Well No.

Mail this copy to Board of Water Commissioners 429 Miss. St. Jackson, Miss

