

Wayne
 Z13
 6-67

MISSISSIPPI
 BOARD OF WATER COMMISSIONERS
 416 North State Street
 Jackson, Mississippi 39201

WATER WELL DRILLERS LOG

June 2 1967 Porter Drilling Co. Wayne
 date well completed firm name county well located

LANDOWNER: Babe Deaman

description of formations encountered	from	to
	red clay & sand	0
Chalk	15	79
thin rock		79
Chalk	79	99
sand	99	104


Box 1 Buckatuna Miss
 (mailing address)

WELL LOCATION:
 sec. 11 T. 6 N R. 5 E
 S E W
 4 miles S W of Buckatuna
 (distance) (direction) (nearest town)

WELL PURPOSE: home
 (home, irrigation, municipal, industrial)


- WELL COMPLETION DATA:
- (1) diameter (inches) 2"
 - (2) total depth (feet) 104'
 - (3) static water level (feet) 55' above top of ground.
 - (4) casing steel 99'
 (material) (depth)
 2" (size) if telescope see back.
 - (5) screen 5' 99'
 (length) (depth to top)
 1/4" 8 slot Johnson S.S.
 (size) (material)
 - (6) pump 3/4 7
 (HP) (yield gpm)
 elec
 (type power)
 - (7) electric log no
 (yes or no)
 (organization running log)
 - (8) how well bottom plugged
 flush screen

DRILLERS REMARKS:

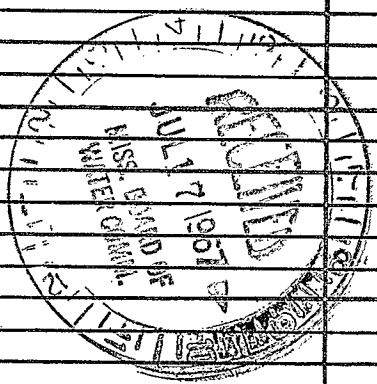

If well telescopes please sketch and show depths.

GROUND LEVEL

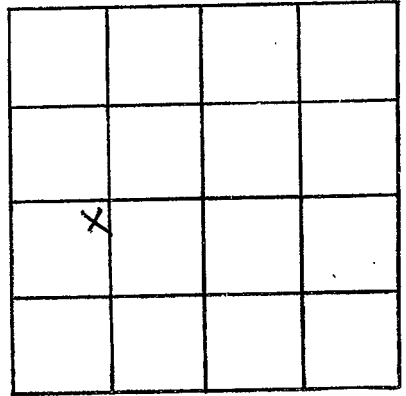

SECTION 11

Please indicate well location X.

ADDITIONAL INFORMATION

If more than one screen, show locations of each on sketch.