

MISSISSIPPI
 BOARD OF WATER COMMISSIONERS
 416 North State Street
 Jackson, Mississippi 39201

WATER WELL DRILLERS LOG

Wayne
 Z14
 9-67

Sept. 19 67 Peoples Drilling Co. Wayne
 date well completed firm name county well located

LANDOWNER: Gerry Revette
 Buckatuna, Miss.

(mailing address)

description of formations encountered

from

to

yellow sand & gravel	0	58
green shale	58	118
yellow sand	168	165
White sandy clay	165	221
Coarse yellow sand	221	301
Lime & limestone	301	347
White sand	347	382

WELL LOCATION:

sec. 19 T. 6^N R. 5^E
 S W
 2 1/2 miles N.W. of State Line
 (distance) (direction) (nearest town)


WELL PURPOSE: Home
 (home, irrigation, municipal, industrial)

WELL COMPLETION DATA:

- (1) diameter (inches) 4
- (2) total depth (feet) 382
- (3) static water level (feet) 8 below top of ground
- (4) casing iron 336 (material) (depth)
 4 in. if telescope see back. (size)
- (5) screen 12' 354' (length) (depth to top)
 2" brass (size) (material)
- (6) pump 1/2 15 (HP) (yield gpm)
 electric (type power)
- (7) electric log no (yes or no)
 (organization running log)


(8) how well bottom plugged Back-wash Valve

DRILLERS REMARKS:

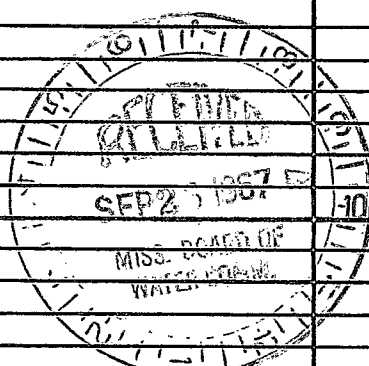

If well telescopes please sketch and show depths.

GROUND LEVEL

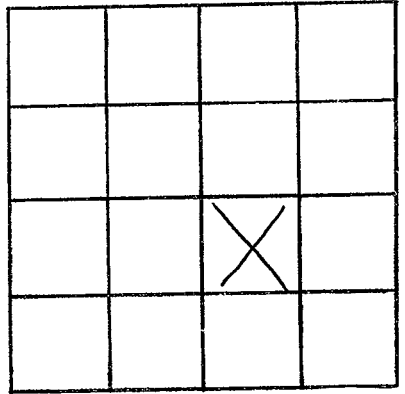

SECTION 19

Please indicate well location X.

ADDITIONAL INFORMATION

If more than one screen, show locations of each on sketch.