

Wayne
Z15
9-66

MISSISSIPPI BOARD OF WATER COMMISSIONERS

WATER WELL DRILLERS LOG

Date: Sept 16, 1966, Driller: Porter Drilling & Log, County: Wayne
(Name)

(1) Owner of Land: L.E. Young
(Name)
At 2 State Line
(Address)

(2) Location: SW 1/4, SW 1/4, Sec. 21 T6 R5
5 miles S of Buckatunga
(distance) (direction) (Nearest Town)

(3) Topography: Hilly
(Hilly) (Flat) (Level)

(4) Purpose of Well: domestic
(Domestic Irrigation
Municipal, Industrial, Other)

Description & Color of Materials Sand, Clay, Red Clay, Shell, etc.	Thick- ness Feet	Depth Feet
<u>red clay</u>	<u>8</u>	<u>8</u>
<u>Chalk</u>	<u>18</u>	<u>26</u>
<u>fine sand</u>	<u>11</u>	<u>37</u>
<u>med. sand</u>	<u>4</u>	<u>41</u>
<u>thin rocks</u>		<u>41</u>
<u>Chalk</u>	<u>1</u>	<u>42</u>

Information upon completion of well:

(1) Diameter 2" inches.

(2) Total Depth 41' feet.

(3) Water Level 29' feet below top of ground.


(4) Cased to 37', Size 2"

(5) Screen: Size 2", Length 4'
10 slot Johnson S.S.

(6) Were any formations sealed against pollution?
no

If YES depth of formation _____
Why _____

Drillers Remarks: _____

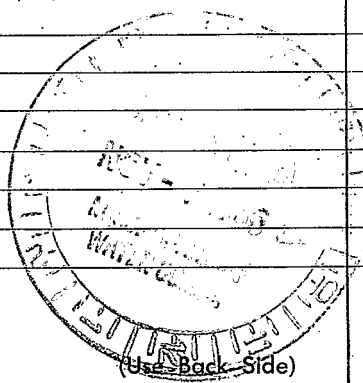

Well No.

