

Wayne

MISSISSIPPI BOARD OF WATER COMMISSIONERS

Z/b

9-66

WATER WELL DRILLERS LOG

Date: Sept. 15, 1966, Driller: Porter Drilling & Supply County Wayne
(Name)

(1) Owner of Land: L. J. Pope
(Name)

At 1 State Line
(Address)

(2) Location: NW 1/4, NE 1/4, Sec. 26 T. 6 R. 5

6 miles S. E, of Buckatunna
(distance) (direction) (Nearest Town)

(3) Topography: flat
(Hilly) (Flat) (Level)

(4) Purpose of Well: domestic
(Domestic Irrigation
Municipal, Industrial, Other)

Description & Color of Materials Sand, Clay, Red Clay, Shell, etc.	Thick- ness Feet	Depth Feet
<u>Chalk</u>	<u>18</u>	<u>18</u>
<u>red sand</u>	<u>17</u>	<u>35</u>
<u>chalk</u>	<u>1</u>	<u>36</u>

Information upon completion of well:

(1) Diameter 2" inches, Copper pipe

(2) Total Depth 35' feet.

(3) Water Level 18' feet below top of ground.

(4) Cased to 30', Size 2"

(5) Screen: Size 1 1/4", Length 5'


7 slot Johnson S.S. screened on case

(6) Were any formations sealed against pollution?
no

If YES depth of formation _____

Why _____

Drillers Remarks: _____

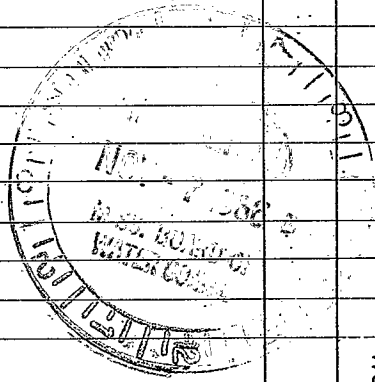

(Use Back Side)

Well No.

