

WAYNE
721
8-68

MISSISSIPPI
BOARD OF WATER COMMISSIONERS
416 North State Street
Jackson, Mississippi 39201

CODED

WATER WELL DRILLERS LOG

8/3 date well completed
1968 CORRS WATERWELL SERVICE firm name
WAYNE county well located

LANDOWNER: James E. Smith
State Line Miss
Rt 2
(mailing address)

description of formations encountered	from	to
Tap soil	0	3
yellow pink & red clay	3	7
yellow GRAY CLAY	7	15
Pink clay	15	35
COARSE Red SD	35	39
Red SD & ROCKY		
THICK WENIN SD		59
LAST RETURNS		

WELL LOCATION:
sec 21 T 6 N R 5 E
2 1/2 miles NNW of State Line
(distance) (direction) (nearest town)

WELL PURPOSE:
(home, irrigation, municipal, industrial)

WELL COMPLETION DATA:

(1) diameter (inches) 2"

(2) total depth (feet) 59

(3) static water level (feet) 39 below top of ground.

(4) casing GALV 54' (material) (depth)

(size) If telescope see back.

(5) screen 5" 54' (length) (depth to top)

1/4" Stainless (size) (material)


(6) pump 1/2 HP 6 (yield gpm)

Elect (type power)

(7) electric log No (yes or no)

(organization running log)


(8) how well bottom plugged 1/4 plug

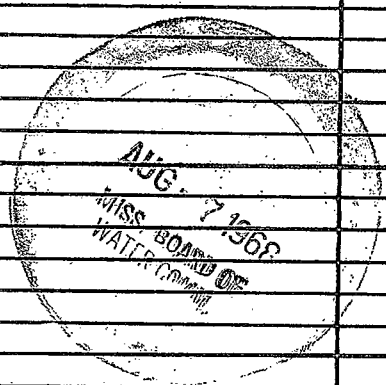

DRILLERS REMARKS: Screen set on Eureka
Cylinder

If well telescopes please sketch and show depths.

GROUND LEVEL

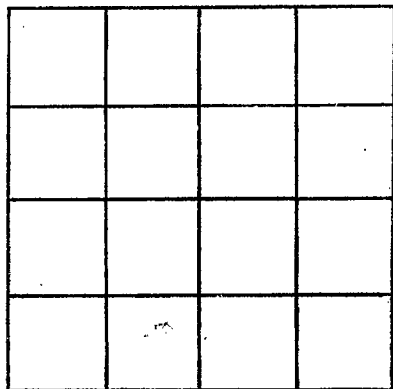

SECTION _____

Please indicate well location X.

ADDITIONAL INFORMATION

LAST TEST WAS WHEN
WENT THROUGH 1/2" OF
RED SD ROCK @ 30'
DRILLED ON TO 50' BY
APPROX
TESTED WELL FOR 1 HR
@ 10 P.M.

If more than one screen,
show locations of each on sketch.