

WAYNE
222
10-68

MISSISSIPPI
BOARD OF WATER COMMISSIONERS
416 North State Street
Jackson, Mississippi 39201



WATER WELL DRILLERS LOG

Oct 19 68 Peoples Drilling Co Wayne
date well completed firm name county well located


LANDOWNER: A G Hewitt
Buckatanna, Miss
(mailing address)

WELL LOCATION:
sec. 30 T. 20 N. R. 5 E
2 miles NW of Statefair
(distance) (direction) (nearest town)

WELL PURPOSE: Home
(home, irrigation, municipal, industrial)

- WELL COMPLETION DATA:
- (1) diameter (inches) 4
 - (2) total depth (feet) 279
 - (3) static water level (feet) 15 below top of ground.
 - (4) casing Iron, 210 (material), (depth)
4" (size) if telescope see back.
 - (5) screen 6', 273 (length), (depth to top)
2", BRASS (size), (material)
 - (6) pump NONE (HP), (yield gpm)
(type power)
 - (7) electric log NO (yes or no)
(organization running log)
 - (8) how well bottom plugged Back Wash Valve


description of formations encountered	from	to
Yellow Sandy clay	18	18
Yellow sand	18	38
Blue sandy clay + sand streaks	38	144
White sand	144	158
Blue sandy clay	158	189
White clay	189	228
White sand	228	279

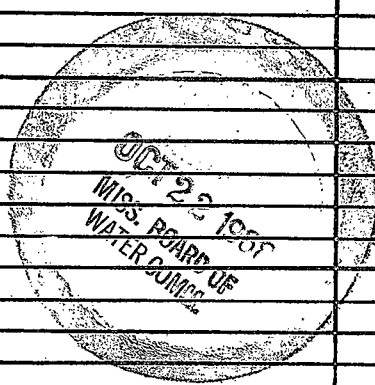

DRILLERS REMARKS:

If well telescopes please sketch and show depths.

GROUND LEVEL

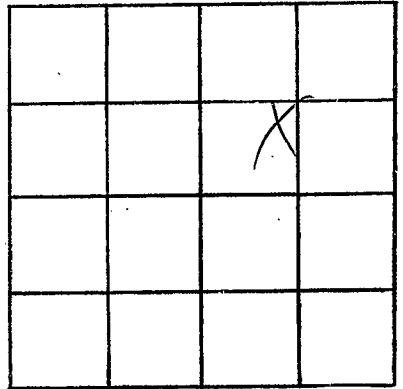

SECTION 30

Please indicate well location X.

ADDITIONAL INFORMATION

If more than one screen,
show locations of each on sketch.