

Wayne
 Z 23
 8-68

MISSISSIPPI
 BOARD OF WATER COMMISSIONERS
 416 North State Street
 Jackson, Mississippi 39201


WATER WELL DRILLERS LOG

CODED
 CODED
Aug 27 1968 date well completed
 J. C. Bentley firm name
 county well located

LANDOWNER: J. C. Bentley	description of formations encountered	from	to
W 2 State Line (mailing address)	sand ch. bl.	0	30
WELL LOCATION: sec. 10 T 6 N R 5 E 4 miles SE of <u>Carthage</u> (distance) (direction) (nearest town)	sand ch. bl.	30	32
WELL PURPOSE: <u>None</u> (home, irrigation, municipal, industrial)	blue ch. bl.	37	40
WELL COMPLETION DATA:	sand	40	42
(1) diameter (inches) <u>2"</u>	sand ch. bl.	42	46
(2) total depth (feet) <u>25'</u>	sand	46	73
(3) static water level (feet) <u>69'</u> below top of ground.	sand ch. bl.	73	75
(4) casing <u>steel</u> , <u>75'</u> (material) (depth)	sand ch. bl.	75	82
<u>2"</u> (size) if telescope see back.	sand	82	85
(5) screen <u>5'</u> , <u>70'</u> (length) (depth to top)	silty sand white shell on surface. Good circulation at bottom.		
(6) pump <u>3/4 HP</u> , <u>3 1/2</u> (HP) (yield gpm)	6 1/2" 1 1/2" long pipe in screen part of 1" thick cylinder		
(7) electric log _____ (yes or no)			
(8) how well bottom plugged _____			
DRILLERS REMARKS:			

NOT RECORDED

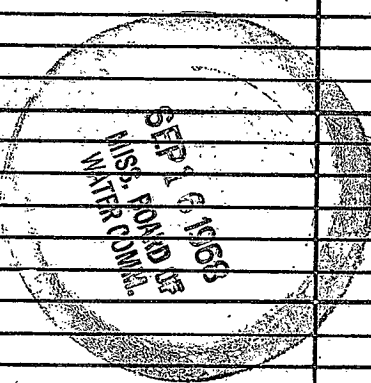

If well telescopes please sketch and show depths.

GROUND LEVEL

		X	

SECTION 10

Please indicate well location X.

ADDITIONAL INFORMATION

If more than one screen,
show locations of each on sketch.