

Wayne
 226
 5-69

MISSISSIPPI
 BOARD OF WATER COMMISSIONERS
 416 North State Street
 Jackson, Mississippi 39201

WATER WELL DRILLERS LOG

May 19 69 Peeples Drilling Co. Wayne
 date well completed firm name county well located

LANDOWNER: ~~Kate Pittman~~
 Kate Pittman
 RFD State Lane
 (mailing address)

WELL LOCATION:
 sec. 17 T. 6 N. R. 5 E.
 S W
 4 miles N of State Lane
 (distance) (direction) (nearest town)

description of formations encountered	from	to
Yellow sandy clay	0	18
Yellow sand & small clay streak	18	47
white sand	47	153

WELL PURPOSE: Home
 (home, irrigation, municipal, industrial)

WELL COMPLETION DATA:

(1) diameter (inches) _____

(2) total depth (feet) 153

(3) static water level (feet) 43 below top of ground.

(4) casing Galv. 147'
 (material) (depth)
2' if telescope see back.
 (size)

(5) screen 4' 147'
 (length) (depth to top)
2' Brass
 (size) (material)

(6) pump 1/2 10
 (HP) (yield gpm)
elct
 (type power)

(7) electric log no
 (yes or no)

 (organization running log)


(8) how well bottom plugged Back
Well valid

MAY 20 1969
 MISS. BD. OF
 WATER COMM.

DRILLERS REMARKS:

If well telescopes please sketch and show depths.

GROUND LEVEL

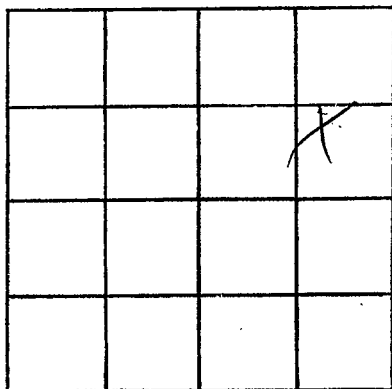

SECTION 17

Please indicate well location X.

ADDITIONAL INFORMATION

If more than one screen,
show locations of each on sketch.