

Wayne
 Z 27
 5-2-69

MISSISSIPPI
 BOARD OF WATER COMMISSIONERS
 416 North State Street
 Jackson, Mississippi 39201

CODED

WATER WELL DRILLERS LOG

date well completed June 2 1969 firm name Boyle Drilling Co county well located Wayne

LANDOWNER:	description of formations encountered	from	to
<u>Little Mac Realty</u>	<u>soft clay</u>	<u>0</u>	<u>2</u>
<u>212 State Line, Minn</u> (mailing address)	<u>orange sand</u>	<u>2</u>	<u>26</u>
	<u>chalk sand</u>	<u>26</u>	<u>36</u>
	<u>yellowish sand</u>	<u>36</u>	<u>42</u>
	<u>orange sand</u>	<u>42</u>	<u>48</u>
	<u>bluish sand</u>		
	<u>green silt. clay</u>		
	<u>to in sand</u>	<u>48</u>	<u>52</u>
	<u>water table</u>		
	<u>1 in sand</u>		

WELL LOCATION:
 sec 7 T 1 N 5 R 5 E
32 miles S of Franklin
 (distance) (direction) (nearest town)

WELL PURPOSE:
 (home, irrigation, municipal, industrial)

WELL COMPLETION DATA:

(1) diameter (inches) 2"

(2) total depth (feet) 42

(3) static water level (feet) 18 below above top of ground.

(4) casing steel 36
 (material) (depth)
2" if telescope see back.
 (size)

(5) screen 6' 36
 (length) (depth to top)
1/2" bronze S.S.
 (size) ((material))

(6) pump 1/2 25
 (HP) (yield gpm)
elec
 (type power)

(7) electric log yes
 (yes or no)

(organization running log)

(8) how well bottom plugged black cement


JUN 2 - 1969

MISS. BD. OF
 WATER COMMISSIONERS

DRILLERS REMARKS:
33' 1" bottom drop
paper

If well telescopes please sketch and show depths.

GROUND LEVEL

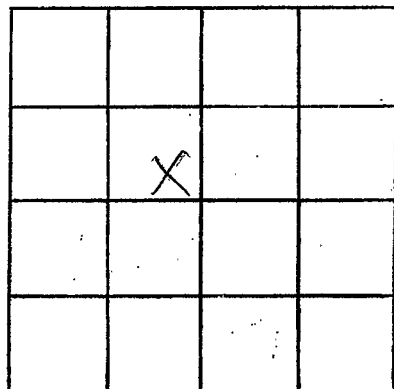

SECTION 8

Please indicate well location X.

ADDITIONAL INFORMATION

If more than one screen, show locations of each on sketch.