

WAYNE
7/29
5-24-65

MISSISSIPPI BOARD OF WATER COMMISSIONERS

WATER WELL DRILLERS LOG

CODED

Date: 5/24, 1965, Driller: TERRY County WAYNE

(1) Owner of Land: <u>STATE Hwy Dept</u> (Name)	Description & Color of Materials Sand, Clay, Red Clay, Shell, etc.	Thick- ness Feet	Depth Feet
<u>JACKSON, MISS</u> (Address)	<u>yellow clay & GRAVEL</u>	<u>40'</u>	<u>40'</u>
(2) Location: <u>1/4, 1/4, Sec. 35 6N 5W T R</u>	<u>WHITE SAND</u>	<u>15'</u>	<u>55'</u>
<u>20</u> miles <u>S</u> , of <u>WAYNESBORO</u> (distance) (direction) (Nearest Town)	<u>BLUE dirt & FINE SAND</u>	<u>55'</u>	<u>110'</u>
(3) Topography: <u>FLAT</u> (Hilly) (Flat) (Level)	<u>BLUE dirt</u>	<u>90'</u>	<u>200'</u>
(4) Purpose of Well: <u>WEIGHING SCALES</u> (Domestic, Irrigation, Municipal, Industrial, Other)	<u>SANDY</u>	<u>39'</u>	<u>239'</u>


Information upon completion of well:

- (1) Diameter 2 inches.
- (2) Total Depth 239 feet.
- (3) Water Level 124 feet below top of ground.
- (4) Cased to 234, Size 2"
- (5) Screen: Size 2", Length 6'
- (6) Were any formations sealed against pollution?
 yes, no.

If YES depth of formation _____

Why _____

Drillers Remarks: pumps about 7 gpm

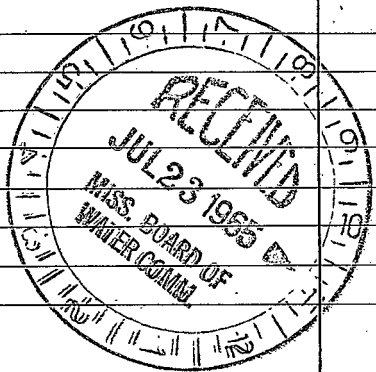

(Use Back Side)

Well No.

Dear Sir,

I have the honor to acknowledge the receipt of your letter of the 14th inst. in relation to the above matter. The same has been referred to the proper authorities for their consideration.

I am, Sir, very respectfully,
Yours truly,
[Signature]

[Name]
[Title]

[Address]

[City, State]

[Telephone Number]

[Additional Information]