

WAYNE
 230
 9-69

MISSISSIPPI
 BOARD OF WATER COMMISSIONERS
 416 North State Street
 Jackson, Mississippi 39201

CODED

WATER WELL DRILLERS LOG

Aug 19 69 Peoples Drilling Co Wayne
 date well completed firm name county well located

LANDOWNER:	description of formations encountered	from	to
Clyde Dobson	Yellow Sand	0	39
Buckatuna, Miss (mailing address)	Yellow Sand & clay	39	147
WELL LOCATION: sec. 6 T 17 N R 5 E 1 miles SW of Buckatuna (distance) (direction) (nearest town)	Yellow Sand	147	215
	Yellow Sandy clay	215	282
WELL PURPOSE: Home (home, irrigation, municipal, industrial)	White Sand	282	298
WELL COMPLETION DATA: (1) diameter (inches) 4" (2) total depth (feet) 462' (3) static water level (feet) 18 below top of ground. (4) casing Mason 336' (material) (depth) 4" (size) if telescope see back. (5) screen NONE (length) (depth to top) (size) (material) (6) pump NONE (HP) (yield gpm) (type power) (7) electric log No (yes or no) (organization running log) (8) how well bottom plugged Open	Blue Clay	298	330
	Lime Rock	330	399
	Lime Rock Sandstone	399	462


OCT 15 1969

DRILLERS REMARKS:

MISS. BD. OF
 WATER COMM.

If well telescopes please sketch and show depths.

GROUND LEVEL

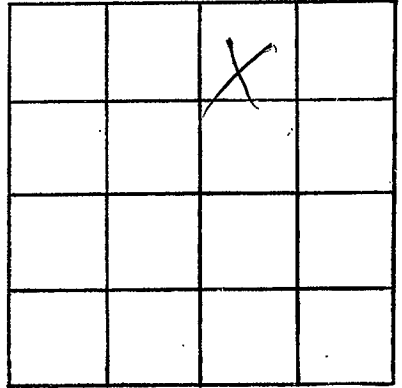

SECTION 6

Please indicate well location X.

ADDITIONAL INFORMATION

If more than one screen,
show locations of each on sketch.