

Wayne
 231
 12-29-69

MISSISSIPPI
 BOARD OF WATER COMMISSIONERS
 416 North State Street
 Jackson, Mississippi 39201

CODED

WATER WELL DRILLERS LOG

12/29/69 19 Laton Well Co. Wayne
 date well completed firm name county well located

LANDOWNER:

Worren Bailey
 State Line Press
 (mailing address)

description of formations encountered

description of formations encountered	from	to
Sandy clay	0	20
clay	20	28
Sand	28	40

WELL LOCATION:

sec. 26 T. 6 N. R. 5 E
 NW 1/4 1st 1/4 of State Line
 miles from of State Line
 (distance) (direction) (nearest town)

WELL PURPOSE:

(home, irrigation, municipal, industrial)

WELL COMPLETION DATA:


- (1) diameter (inches) 2 in
- (2) total depth (feet) 42
- (3) static water level (feet) 28 below top of ground.
- (4) casing 3/4" 38 ft (material) (depth)
 if telescope see back.
 (size)
- (5) screen 4 ft (length) (depth to top)
 2 in stainless (size) (material)
- (6) pump 1/2 HP 3 BHP (HP) (yield gpm)
 Elec (type power)
- (7) electric log (yes or no)
 (organization running log)
- (8) how well bottom plugged Bkwd

DRILLERS REMARKS:

JAN 6 1970
 MISSISSIPPI
 WATER BOARD

If well telescopes please sketch and show depths.

GROUND LEVEL

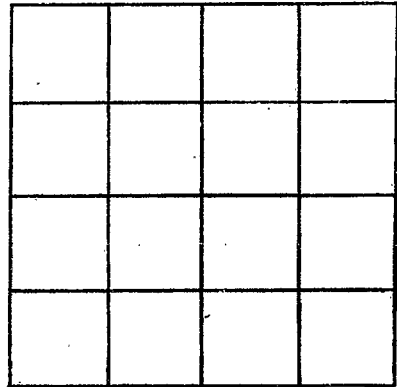

SECTION _____

Please indicate well location X.

ADDITIONAL INFORMATION

If more than one screen,
show locations of each on sketch.