

Wayne  
 232  
 12-22-69

MISSISSIPPI  
 BOARD OF WATER COMMISSIONERS  
 416 North State Street  
 Jackson, Mississippi 39201

CODED  
 CODED

WATER WELL DRILLERS LOG

Dec 22 1969 Porter Drilling & Supply Wayne  
 date well completed firm name county well located


LANDOWNER: <u>Mr J. G. Weston</u>	description of formations encountered	from	to
<u>At 2 State Line Miss</u> (mailing address)	<u>wet clay</u> <u>sand</u> <u>stagnant rubble</u> <u>still in sand</u>	<u>0</u>	<u>8</u> <u>72</u>
WELL LOCATION: sec. <u>8</u> T. <u>60</u> N. R. <u>5</u> E. W. <u>3</u> (distance) miles (direction) of <u>Memphis</u> (nearest town)	<u>5' Johnson sand with</u>		
WELL PURPOSE: <u>Home</u> (home, irrigation, municipal, industrial)	<u>2' 1 1/2' log section in well</u>		
WELL COMPLETION DATA: (1) diameter (inches) <u>2"</u> (2) total depth (feet) <u>72</u> (3) static water level (feet) <u>30</u> <u>below</u> top of ground. (4) casing <u>steel</u> , <u>65 1/2'</u> (depth) <u>2"</u> (size) if telescope see back. (5) screen <u>5'</u> (length), <u>67'</u> (depth to top) <u>1 1/2"</u> (size), <u>balch S.S.</u> (material) (6) pump <u>3/4</u> (HP), <u>9</u> (yield gpm) <u>elec.</u> (type power) (7) electric log <u>no</u> (yes or no) (organization running log) (8) how well bottom plugged <u>flush around</u>	<u>packer</u> <u>4 1/2' 1 1/2" drags pipe</u>		
DRILLERS REMARKS:			

JAN 12 1970

MISS. BD. OF  
 WATER COMM.

If well telescopes please sketch and show depths.

GROUND LEVEL

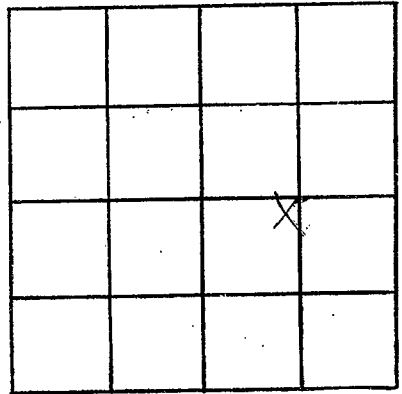

SECTION 8

Please indicate well location X.

ADDITIONAL INFORMATION

If more than one screen, show locations of each on sketch.