

Wayne
 Z 33
 3-9-70

MISSISSIPPI
 BOARD OF WATER COMMISSIONERS
 416 North State Street
 Jackson, Mississippi 39201

CODED

WATER WELL DRILLERS LOG

3/9 1970 Platon Well Service Wayne
 date well completed firm name county well located

LANDOWNER:
Jessie Lee Rogers
State Line Miss
 (mailing address)

description of formations encountered	from	to
Clay	0	29
Sand clay	29	48
Sand	48	60

WELL LOCATION:
 sec. 8 T. 6 N. R. 5 W.
2 mi. miles So. of Bricatung
 (distance) (direction) (nearest town)

WELL PURPOSE: Home use
 (home, irrigation, municipal, industrial)

- WELL COMPLETION DATA:
- (1) diameter (inches) 2
 - (2) total depth (feet) 60
 - (3) static water level (feet) 36 below above top of ground.
 - (4) casing Galv Pipe
 (material) (depth)
 - (size) if telescope see back.
 - (5) screen 4" 56'
 (length) (depth to top)
 - 2" 20' 5'
 (size) (material)
 - (6) pump 1 10 PM
 (HP) (yield gpm)
 - Spec
 (type power)
 - (7) electric log
 (yes or no)
 - (organization running log)
 - (8) how well bottom plugged

CODED


APR - 9 1970

MISS. Bd. of
 WATER COMMISSIONERS

DRILLERS REMARKS:

If well telescopes please sketch and show depths.

GROUND LEVEL

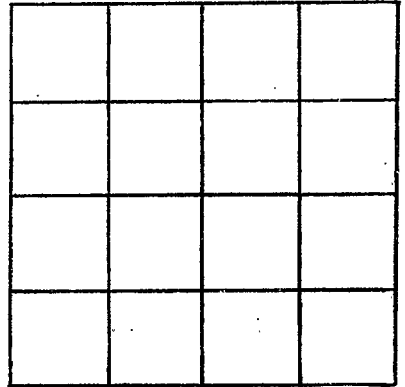

SECTION _____

Please indicate well location X.

ADDITIONAL INFORMATION

If more than one screen,
show locations of each on sketch.