

Wayne
 Z 34
 4-3-70

MISSISSIPPI
 BOARD OF WATER COMMISSIONERS
 416 North State Street
 Jackson, Mississippi 39201

WATER WELL DRILLERS LOG

4/3 1970 Lagoon Well Service Wayne
 date well completed firm name county well located

LANDOWNER: Lillie

description of formations encountered

from to

Ma Lillie Woods
 State Line
 (mailing address) miss

Red Clay	0	22
Clay & Sandst	22	48
Sand	40	50
Clay Strub	50	55
Sand	55	70

WELL LOCATION:

sec. 9 T. 6 N. R. 5
 3 1/2 miles S. of Breauxville
 (distance) (direction) (nearest town)

WELL PURPOSE: home
 (home, irrigation, municipal, industrial)

WELL COMPLETION DATA:

- (1) diameter (inches) 2 in
- (2) total depth (feet) 70
- (3) static water level (feet) 58 below top of ground.
- (4) casing Galv. 63 ft. (material) (depth)
- (size) If telescope see back.
- (5) screen 5 ft. 63 ft. (length) (depth to top)
- 2 in. Galv. (size) (material)
- (6) pump 1 (HP) 10 (yield gpm)
- Elig (type power)

(7) electric log (yes or no)

(organization running log)

(8) how well bottom plugged *Pl. w/*

DRILLERS REMARKS:


CODED

APR - 9 1970

MISS. BD. OF
 WATER COMM.

If well telescopes please sketch and show depths.

GROUND LEVEL

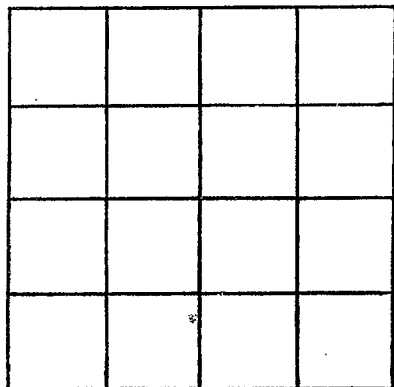

SECTION _____

Please indicate well location X.

ADDITIONAL INFORMATION

If more than one screen,
show locations of each on sketch.