

Wayne
 Z 35
 9-10-70

MISSISSIPPI
 BOARD OF WATER COMMISSIONERS
 416 North State Street
 Jackson, Mississippi 39201

CODED

WATER WELL DRILLERS LOG

Sept. 10, 1970 Haentel's Well Service Wayne
 date well completed firm name county well located

LANDOWNER: Evan Cramer
State Line, Miss.
 (mailing address)

WELL LOCATION:
 sec. 26 T. 6 S. R. 5 E.
2 1/2 miles east of State Line
 (distance) (direction) (nearest town)

WELL PURPOSE: home
 (home, irrigation, municipal, industrial)

- WELL COMPLETION DATA:
- (1) diameter (inches) 2"
 - (2) total depth (feet) 157 ft.
 - (3) static water level (feet) 24 ft. below above top of ground.
 - (4) casing P.V.C. 152 ft.
 (material) (depth)
2" If telescope see back.
 (size)
 - (5) screen 5 ft. 152 ft.
 (length) (depth to top)
2" P.V.C.
 (size) (material)
 - (6) pump 1 hp 8 gpm
 (HP) (yield gpm)
electric
 (type power)
 - (7) electric log no
 (yes or no)
 (organization running log)
 - (8) how well bottom plugged 2" pipe plug

| description of formations encountered | from | to |
|---------------------------------------|------|-----|
| top soil | 0 | 1 |
| clay (red, pink white) | 1 | 16 |
| yellow sand | 16 | 22 |
| clay (yellow & pink) | 22 | 30 |
| yellow fine sand | 30 | 32 |
| yellow sandy clay | 32 | 36 |
| blue & grey clay | 36 | 72 |
| white & grey clay | 72 | 100 |
| blue hard clay | 100 | 140 |
| sand (white) & clay (grey) | 140 | 157 |
| | 157 | 158 |

CODED


SEP 22 1970

MISS. BD. OF WATER COMMISSIONERS

DRILLERS REMARKS:

If well telescopes please sketch and show depths.

GROUND LEVEL

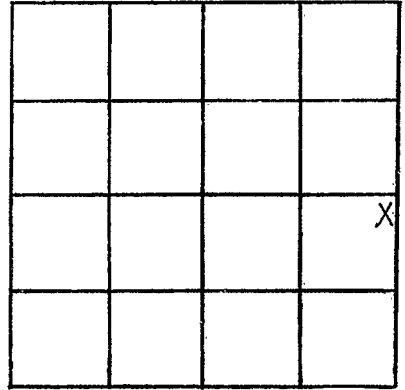

SECTION 26

Please indicate well location X.

ADDITIONAL INFORMATION

If more than one screen, show locations of each on sketch.