

WAYNE
 E 37
 B-12-71

MISSISSIPPI
 BOARD OF WATER COMMISSIONERS
 416 North State Street
 Jackson, Mississippi 39201

CODED

WATER WELL DRILLERS LOG

March 12 1971 Herantel's Well Service Wayne
 date well completed firm name county well located

LANDOWNER: J. J. Crager

State Line, Miss.

(mailing address)

description of formations encountered	from	to
	<u>sandy loam</u>	<u>0</u>
<u>sandy clay</u>	<u>1</u>	<u>12</u>
<u>clay (sticky)</u>	<u>12</u>	<u>32</u>
<u>sand</u>	<u>32</u>	<u>50</u>
<u>clay</u>	<u>50</u>	<u>51</u>

WELL LOCATION:

sec. 35 T 6 (N) R 5 E
 S W
1/2 miles EAST of State Line
 (distance) (direction) (nearest town)

WELL PURPOSE:
 (home, irrigation, municipal, industrial)

WELL COMPLETION DATA:

- (1) diameter (inches) 2 in.
- (2) total depth (feet) 50 ft.
- (3) static water level (feet) 36 ft. ^{below} top of ground
- (4) casing P.V.C. 45 ft.
 (material) (depth)
- (size) If telescope see back.
- (5) screen 5 ft. 45 ft.
 (length) (depth to top)
- 2" P.V.C.
 (size) (material)
- (6) pump 1 hp. 7 1/2 gpm
 (HP) (yield gpm)
- electric
 (type power)
- (7) electric log no
 (yes or no)
- (organization running log)
- (8) how well bottom plugged 2" pipe plug

CODED


APR - 9 1971

MISS. SD. OF
 WATER CONTROL

DRILLERS REMARKS:

If well telescopes please sketch and show depths.

GROUND LEVEL

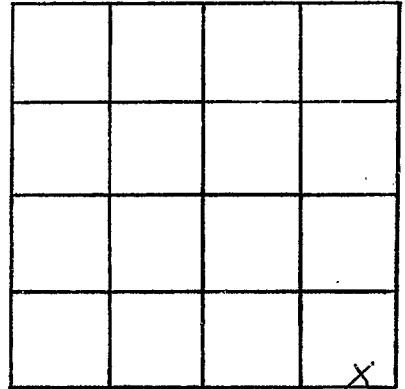

SECTION 35

Please indicate well location X.

ADDITIONAL INFORMATION

If more than one screen, show locations of each on sketch.