

WAYNE
 E 39
 6-71

MISSISSIPPI
 BOARD OF WATER COMMISSIONERS
 416 North State Street
 Jackson, Mississippi 39201

CODED

WATER WELL DRILLERS LOG

June 19 71 Peoples Drilling Co Wayne
 Date well completed firm name county well located

LANDOWNER: A.C. Kewitt

State Line, Miss.

(mailing address)

WELL LOCATION:

sec 30 T 6N R 5 E
 S W
 3 miles NW of State Line
 (distance) (direction) (nearest town)

WELL PURPOSE: FISH POND
 (home, irrigation, municipal, industrial)

WELL COMPLETION DATA:

- (1) diameter (inches) 4
- (2) total depth (feet) 294
- (3) static water level (feet) 18 below above top of ground.
- (4) casing Iron 190 (material) (depth)
 4' (size) if telescope see back.
- (5) screen 10' 284' (length) (depth to top)
 2 1/2" stainless steel (size) (material)
- (6) pump 3 50 (HP) (yield gpm)
 electric (A-R Comp.) (type power)
- (7) electric log no (yes or no)
- (organization running log)
- (8) how well bottom plugged Back Wash valve

description of formations encountered

from to

yellow sandy clay	0	18
white sand	18	39
yellow sandy clay	39	67
yellow sand	67	84
white clay & small sand streak	84	147
Hard white clay	147	213
yellow sandy clay	213	229
Fine white sand	229	273
Coarse Multi-colored sand	273	294

CODED


JUL 14 1971

MISS. BD. OF
 WATER COM.:

DRILLERS REMARKS:

If well telescopes please sketch and show depths.

GROUND LEVEL

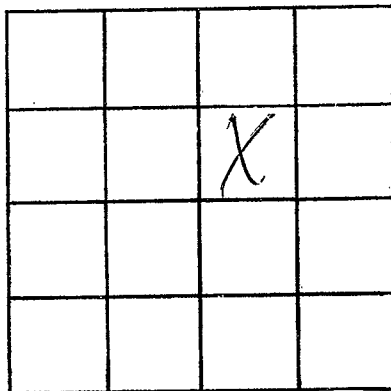

SECTION 30

Please indicate well location X.

ADDITIONAL INFORMATION

If more than one screen, show locations of each on sketch.