

Wayne

Z 43

1-72

MISSISSIPPI
 BOARD OF WATER COMMISSIONERS
 416 North State Street
 Jackson, Mississippi 39201

WATER WELL DRILLERS CODED

Jan 19 72 Peoples Drilling & Wayne
 date well completed firm name county well located

LANDOWNER: Charles Henderson

Rt 1

State Line Miss
 (mailing address)

WELL LOCATION:

sec 9 T 6N R 5E
 3 1/2 miles SE of Buckhorn
 (distance) (direction) (nearest town)

WELL PURPOSE: Home
 (home, irrigation, municipal, industrial)

WELL COMPLETION DATA:

- (1) diameter (inches) 2"
- (2) total depth (feet) 45'
- (3) static water level (feet) 22 ^{below}/_{above} top of ground.
- (4) casing Galv. 44' (material) (depth)
 2" (size) if telescope see back.
- (5) screen 5' 44' (length) (depth to top)
 2" stainless steel (size) (material)
- (6) pump 1/2 12 (HP) (yield gpm)
 electric (type power)
- (7) electric log no (yes or no)

(organization running log)

(8) how well bottom plugged Back Wash valve

DRILLERS REMARKS:

Description of formations encountered	from	to
yellow sandy clay	0	12
yellow sand + sandy clay	12	21
yellow clay	21	35
white sand	35	49


CODED

FEB - 2 1972

MISS. DIV. OF
 WATER RESOURCES

If well telescopes please sketch and show depths.

GROUND LEVEL

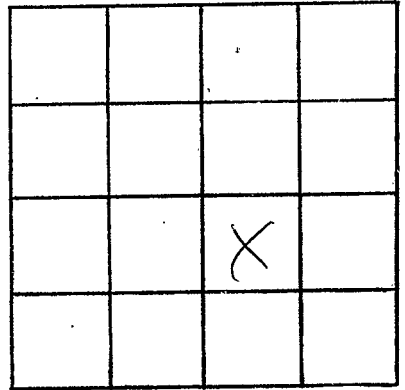

SECTION 9

Please indicate well location X.

ADDITIONAL INFORMATION

If more than one screen, show locations of each on sketch.