

WAYNE
Z 45
5-26-72

MISSISSIPPI
BOARD OF WATER COMMISSIONERS
416 North State Street
Jackson, Mississippi 39201

WATER WELL DRILLERS LOG **CODED**

5-26-1972 date well completed
25 River Water Well Serv Wayne firm name
Wayne county well located


LANDOWNER: <u>Raymond Ruell</u>	description of formations encountered	from	to
<u>Rt 1, Buckatanna, Miss</u> (mailing address)	<u>Red clay</u>	<u>0</u>	<u>20</u>
	<u>Blue chalk</u>	<u>20</u>	<u>37</u>
	<u>Thin to coarse sand</u>	<u>37</u>	<u>65</u>
WELL LOCATION: sec. <u>9</u> T <u>60</u> N R <u>5</u> E <u>5</u> miles <u>South</u> of <u>Buckatanna</u> (distance) (direction) (nearest town)			
WELL PURPOSE: <u>Home</u> (home, irrigation, municipal, industrial)			
WELL COMPLETION DATA:			
(1) diameter (inches) <u>4"</u>			
(2) total depth (feet) <u>65</u>			
(3) static water level (feet) <u>37</u> below above top of ground.			
(4) casing <u>2"</u> <u>62</u> (material) (depth) (size) if telescope see back.			
(5) screen <u>3'</u> <u>65</u> (length) (depth to top) <u>1/4"</u> <u>Brown lined</u> (size) (material)			
(6) pump <u>3/4</u> <u>8</u> (HP) (yield gpm) <u>Electric</u> (type power)			
(7) electric log <u>no</u> (yes or no) (organization running log)			
(8) how well bottom plugged <u>Price Point</u>			
DRILLERS REMARKS: <u>Good</u>			

CODED

JUN 9 1972

If well telescopes please sketch and show depths.

GROUND LEVEL

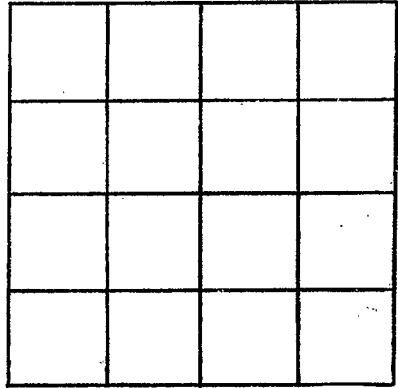

SECTION _____

Please indicate well location X.

ADDITIONAL INFORMATION

If more than one screen, show locations of each on sketch.