

WAYNE  
 Z 46  
 6-14-72

MISSISSIPPI  
 BOARD OF WATER COMMISSIONERS  
 416 North State Street  
 Jackson, Mississippi 39201


WATER WELL DRILLERS LOG

June 14 1972 Porter Drilling Corp Wayne  
 date well completed firm name county well located

LANDOWNER <u>Billy Beasley</u>	description of formations encountered	from	to
<u>212 State Line</u> (mailing address)	<u>red clay</u>	0	15
WELL LOCATION:	<u>red chalk</u>	15	35
sec. <u>10</u> T. <u>60</u> N. R. <u>5</u> E. <u>W1</u>	<u>chalk &amp; sand</u>	35	42
1/4 miles <u>S.E.</u> of <u>Buckatun</u> (distance) (direction) (nearest town)	<u>sand &amp; chalk</u>	42	51
WELL PURPOSE: <u>home</u> (home, irrigation, municipal, industrial)	<u>smooth sand</u>	51	58
WELL COMPLETION DATA:	<u>sand with a little</u>	58	71
(1) diameter (inches) <u>2"</u>	<u>chalk</u>		
(2) total depth (feet) <u>71</u>	<u>stayed on sandy chalk</u>		
(3) static water level (feet) <u>54</u> (below/above top of ground)	<u>6' 1 1/4" 60 ga SS.</u>		
(4) casing <u>steel</u> <u>63'</u> (material) (depth)	<u>with 4' 1 1/4" logs</u>		
<u>2"</u> (size) if telescope see back.	<u>range bent on with</u>		
(5) screen <u>6'</u> <u>65'</u> (length) (depth to top)	<u>gracker</u>		
<u>1 1/4"</u> <u>60 ga SS.</u> (size) (material)	<u>58' 1 1/4" deep pipe</u>		
(6) pump <u>3/4</u> <u>10</u> (HP) (yield gpm)			
<u>elec</u> (type power)			
(7) electric log <u>no</u> (yes or no)			
(organization running log)			
(8) how well bottom plugged <u>flush joint</u>			
DRILLERS REMARKS:	<p>JUN 21 1972</p> <p>MISS. DIV. OF          WATER COMMISSIONERS</p>		

If well telescopes please sketch and show depths.

GROUND LEVEL

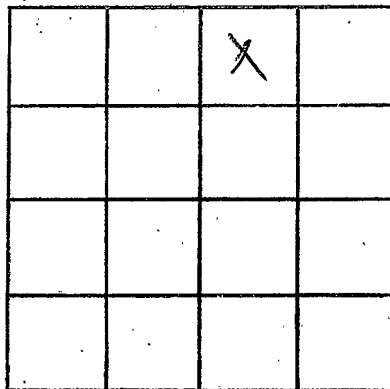

SECTION 10

Please indicate well location X.

ADDITIONAL INFORMATION

A series of horizontal lines for writing additional information.

If more than one screen, show locations of each on sketch.