

Wayne  
 Z 47  
 7-1-72

MISSISSIPPI  
 BOARD OF WATER COMMISSIONERS  
 416 North State Street  
 Jackson, Mississippi 39201

WATER WELL DRILLERS LOG

CLANTON + McILWAIN  
 WATER WELL SER.

WAYNE

July 1, 1972  
 date well completed

firm name

county well located

LANDOWNER:  
 MRS MARY DEES  
 (mailing address)  
 WELL LOCATION: 5 W  
 sec. 3 T. 6 N. R. 1 E  
 17 miles SE of WAYNESBORO  
 (distance) (direction) (nearest town)

description of formations encountered	from	to
	Red Clay + Sand	0
Clay	25	110
Fine Sand	110	113
Clay	113	130
Gravel	130	131
Clay	131	143
Water Sand	143	178

WELL PURPOSE: HOME  
 (home, irrigation, municipal, industrial)

WELL COMPLETION DATA:  
 (1) diameter (inches) 2"  
 (2) total depth (feet) 178'  
 (3) static water level (feet) 85' below top of ground.  
 (4) casing PVC 168' (material) (depth)  
 2" (size) if telescope see back.  
 (5) screen 10' 168' (length) (depth to top)  
 2" PVC .006 (size) (material)  
 (6) pump 1 6 (HP) (yield gpm)  
 110 AC (type power)  
 (7) electric log NO (yes or no)  
 (organization running log)  
 (8) how well bottom plugged BU VALVE.


DATE 1 9 1972  
 JUL 15 1972

DRILLERS REMARKS:

MISS.

If well telescopes please sketch and show depths.

GROUND LEVEL

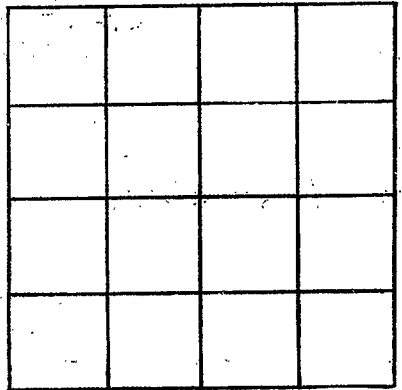

SECTION \_\_\_\_\_

Please indicate well location X.

ADDITIONAL INFORMATION

If more than one screen, show locations of each on sketch.