

Wayne
 Z 48
 8-24-72

MISSISSIPPI
 BOARD OF WATER COMMISSIONERS
 416 North State Street
 Jackson, Mississippi 39201
 WATER WELL DRILLERS LOG

CODED

8-24 1972 CARRS well service WAYNE
 date well completed firm name county well located

LANDOWNER: W.T. CARR	description of formations encountered	from	to
BUCHANNA MISS			
(mailing address)	Tap Soil	0	1
	Yellowish Med SAND	1	9
	CARRS White SAND	9	23

WELL LOCATION:
 sec. 31 T. 6N R. 5E
 S W
 1/2 miles ESE of BUCHANNA
 (distance) (direction) (nearest town)

WELL PURPOSE: ~~Chicken House~~
 (home, irrigation, municipal, industrial)

- WELL COMPLETION DATA:
- (1) diameter (inches) 4" x 2"
 - (2) total depth (feet) 23
 - (3) static water level (feet) 10 ~~below~~ below top of ground.
 - (4) casing PVC, 14' (material) (depth)
 (size) If telescope see back.
 - (5) screen 9' (length), 14' (depth to top)
 2" (size), PVC (material)
 - (6) pump 1/2 (HP), 6 (yield gpm)
 ELECT (type power)
 - (7) electric log No (yes or no)
 (organization running log)
 - (8) how well bottom plugged 2" B.W.V.


CODED

SEP 6 1972

DRILLERS REMARKS: MISS. RD. OF

If well telescopes please
sketch and show depths.

GROUND LEVEL

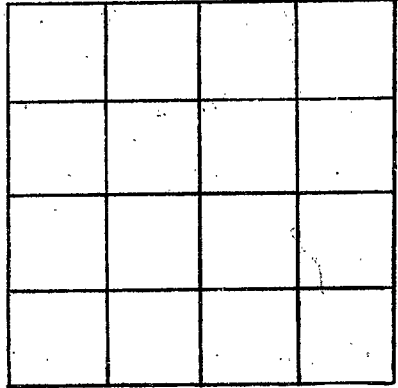

SECTION _____

Please indicate well location X.

ADDITIONAL INFORMATION

A series of horizontal lines for recording additional information.

If more than one screen,
show locations of each on sketch.