

WAYNE
Z 51
1-16-73

MISSISSIPPI
BOARD OF WATER COMMISSIONERS
416 North State Street
Jackson, Mississippi 39201

CODED

WATER WELL DRILLERS LOG


Jan. 16 1973 M. E. Miller Drilling Co. Wayne Co.
date well completed firm name county well located

LANDOWNER: <u>D. J. Orfinger, Jr.</u>	description of formations encountered	from	to
<u>State Line</u> <u>Miss.</u> (mailing address)	<u>Red Clay</u> <u>yellow sand</u> <u>chucky clay</u> <u>water sand</u>	1'	10'
WELL LOCATION: sec. <u>35</u> T <u>6</u> N R <u>5</u> E <u>112</u> miles <u>East</u> of <u>Stations</u> (distance) (direction) (nearest town)			
WELL PURPOSE: <u>Home</u> (home, irrigation, municipal, industrial)			
WELL COMPLETION DATA: (1) diameter (inches) <u>2"</u> (2) total depth (feet) <u>45'</u> (3) static water level (feet) <u>25</u> below above top of ground. (4) <u>no</u> casing <u>Galv pipe</u> (material) (depth). <u>2</u> if telescope see back. (size) (5) screen <u>4'</u> (length) (depth to top) <u>2" x 4'</u> <u>Stainless Steel</u> (size) (material) (6) pump <u>1</u> <u>10 gal.</u> (HP) (yield/gpm) <u>Electric</u> (type power) (7) electric log _____ (yes or no) _____ (organization running log) (8) how well bottom plugged <u>Deck plug</u>			
DRILLERS REMARKS:			

JAN 22 1973

If well telescopes please sketch and show depths.

GROUND LEVEL

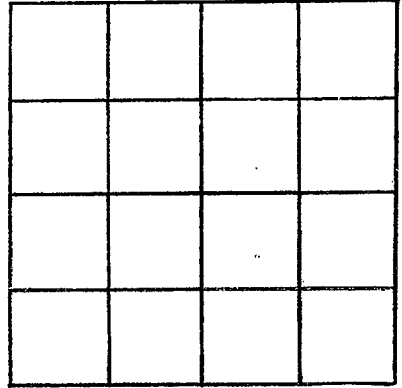

SECTION _____

Please indicate well location X.

ADDITIONAL INFORMATION

If more than one screen, show locations of each on sketch.