

WAYNE
E 52
6-28-73

MISSISSIPPI
BOARD OF WATER COMMISSIONERS
416 North State Street
Jackson, Mississippi 39201

WATER WELL DRILLERS LOG

CODED

6/28 1973 CARAS well service WAYNE
date well completed firm name county well located

LANDOWNER: <u>Bob Williams</u>	description of formations encountered		from	to
<u>R#2 State Lime Miss</u>	<u>Top Soil</u>		<u>0</u>	<u>2</u>
	<u>Yellow + white clay</u>		<u>2</u>	<u>7</u>
	<u>Whit clay</u>		<u>7</u>	<u>15</u>
	<u>DARK GRAY CLAY</u>		<u>15</u>	<u>22</u>
	<u>Med white SAND</u>		<u>22</u>	<u>26</u>
	<u>GRAY CLAY</u>		<u>26</u>	<u>27</u>
	<u>Fine white SAND</u>		<u>27</u>	<u>31</u>
	<u>Blue CLAY CODED</u>		<u>31</u>	<u>34</u>
	<u>Fine white SAND</u>		<u>34</u>	<u>40</u>
	<u>Med white SAND</u>		<u>40</u>	<u>46</u>
	<u>Soft Blue CLAY</u>		<u>46</u>	<u>51</u>

WELL LOCATION:
sec 31 T 6N R 5E
S (W)
2 miles EAST of State Line
(distance) (direction) (nearest town)

WELL PURPOSE: HOME
(home, irrigation, municipal, industrial)


- WELL COMPLETION DATA:
- diameter (inches) 4 1/2 x 2
 - total depth (feet) 46
 - static water level (feet) 10 below top of ground.
 - casing PVC (material), 41 (depth)
if telescope see back.
(size)
 - screen 5' (length), (depth to top)
2" (size), PVC (8 slot) (material)
 - pump 1 (HP), 12 (yield gpm)
Elect (type power)
 - electric log No (yes or no)
(organization running log)
 - how well bottom plugged B.W.V.

DRILLERS REMARKS: _____

OCT 1973

If well telescopes please sketch and show depths.

GROUND LEVEL

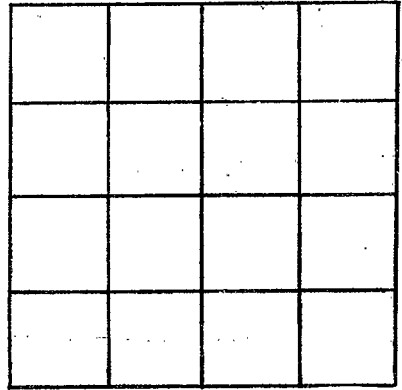

SECTION _____

Please indicate well location X.

ADDITIONAL INFORMATION

If more than one screen,
show locations of each on sketch.