

MISSISSIPPI

MISSISSIPPI
BOARD OF WATER COMMISSIONERS
416 North State Street
Jackson, Mississippi 39201

WATER WELL DRILLERS LOG

CODED

WAYNE

Z53

9-27-73

Sept 27 1973 *Boyer Drilling & Log* Wayne
date well completed firm name county well located

LANDOWNER: *Halle Joe*
Hutto

description of formations encountered from to

Highland Dr. Magnestown
(mailing address)

top soil 0 2
loam chert 2 12
red sand 12 28
chalk 28 31
sand 31 116
clay on chalk

WELL LOCATION:

sec. 7 T. 6 N. R. 5 E.
S. W.
3 miles S of *Highland*
(distance) (direction) (nearest town)

WELL PURPOSE: *camp*
(home, irrigation, municipal, industrial)

WELL COMPLETION DATA:

- (1) diameter (inches) 2"
- (2) total depth (feet) 42'
- (3) static water level (feet) 19' ^{below} 19' ^{above} top of ground.
- (4) casing steel, 36'
(material) (depth)
2' if telescope see back,
(size)
- (5) screen 5', 36'
(length) (depth to top)
1 1/4", bold SS
(size) (material)
- (6) pump 3 1/2, 8
(HP) (yield gpm)
elec.
(type power)
- (7) electric log no
(yes or no)
- (organization running log)
- (8) how well bottom plugged backwash valve


5' 1 1/4" bold SS removed on casing with backwash valve on end
30' 1 1/4" drop pipe

DRILLERS REMARKS:

OCT 9 1973

If well telescopes please
sketch and show depths.

GROUND LEVEL

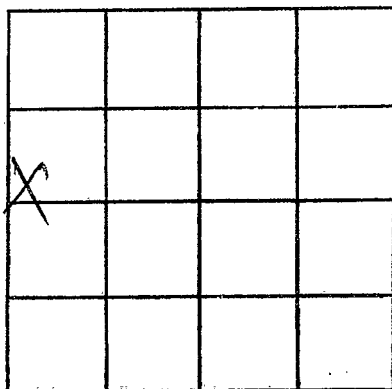

SECTION 7

Please indicate well location X.

ADDITIONAL INFORMATION

If more than one screen,
show locations of each on sketch.