

**WAYNE**  
 Z 54  
 12-11-73

MISSISSIPPI  
 BOARD OF WATER COMMISSIONERS  
 416 North State Street  
 Jackson, Mississippi 39201

**CODED**

**WATER WELL DRILLERS LOG**

12/11/73 date well completed      CARRS well SERV firm name      WAYNE county well located

LANDOWNER: RONNIE GARDNER

R#1 BUCKTENNA MISS  
 (mailing address)

description of formations encountered	from	to
TOP SOIL	0	2
yellow + white CLAY	2	15
GRAYISH CLAY	15	30
Fine yellowish SAND	30	39
Blue CLAY	39	67
yellow CLAY	67	70
Fine white SAND	70	77
Blue CLAY	77	79
Fine white SAND	79	102
Med white SAND	102	112

WELL LOCATION:  
 sec 21 T. 6 N R. 5 E  
4 miles SSE of BYC  
 (distance) (direction) (nearest town)

WELL PURPOSE: Home  
 (home, irrigation, municipal, industrial)

- WELL COMPLETION DATA:
- (1) diameter (inches) 2"
  - (2) total depth (feet) 112
  - (3) static water level (feet) 63 <sup>below</sup> <sub>above</sub> top of ground.
  - (4) casing PVC, 107  
 (material) (depth)  
 (size) if telescope see back.
  - (5) screen 5', 107  
 (length) (depth to top)  
2, PVC (sb + 8)  
 (size) (material)
  - (6) pump 1 7  
 (HP) (yield gpm)  
Elect  
 (type power)
  - (7) electric log No  
 (yes or no)
- (organization running log)
- (8) how well bottom plugged As built  
IN 2" BACK WASH VALVE

**CODED**


DRILLERS REMARKS:

JAN 2 1974

MISSISSIPPI BOARD OF WATER COMMISSIONERS

If well telescopes please sketch and show depths.

GROUND LEVEL

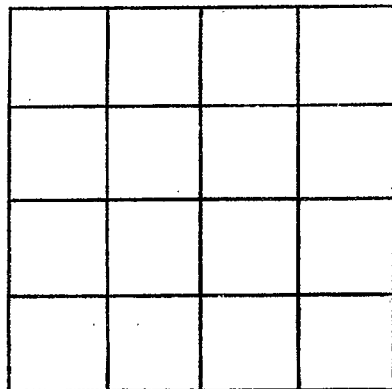

SECTION \_\_\_\_\_

Please indicate well location X.

ADDITIONAL INFORMATION

If more than one screen,  
show locations of each on sketch.