

WAYNE

Z55

1-10-74

MISSISSIPPI BOARD OF WATER COMMISSIONERS
416 North State Street
Jackson, Mississippi 39201

CODED

WATER WELL DRILLERS LOG

Jan 10

1974 Booth & Silling

Wayne

date well completed

firm name

county well located

LANDOWNER: James Hudson

description of formations encountered

from

to

Box 1 Buckatunna
(mailing address)

red clay & sand 0 16

chert 16 93

sand & chert 93 97

chert 97 99

sand soft mud core 99 105

red cherty sand 105 109

WELL LOCATION:

sec. 11 T. 6 N. R. 5 E. 3 miles S.W. of Buckatunna
(distance) (direction) (nearest town)

round red gravel last

4' of sand

WELL PURPOSE:

(home, irrigation, municipal, industrial)

WELL COMPLETION DATA:

80' 1" P.V.C. of pipe

(1) diameter (inches) 2"

11 0 0

(2) total depth (feet) 105'

5' 1 1/2' of red ss

(3) static water level (feet) 53' ^{below} above top of ground.

screwed on end of cas

(4) casing P.V.C. 99 1/2'
(material) (depth)

with steel funnel &

2' if telescope see back.
(size)

back wash valve

(5) screen 5' 100 99 1/2'
(length) (depth to top)

CODED

1 1/4" galv. ss.
(size) (material)

(6) pump 3/4 5
(HP) (yield gpm)

elec.
(type power)

(7) electric log no
(yes or no)

(organization running log)

(8) how well bottom plugged has back wash valve


DRILLERS REMARKS:

RECORDED
JAN 20 1974

MISS. BD. OF WATER COMMISSIONERS

If well telescopes please sketch and show depths.

GROUND LEVEL

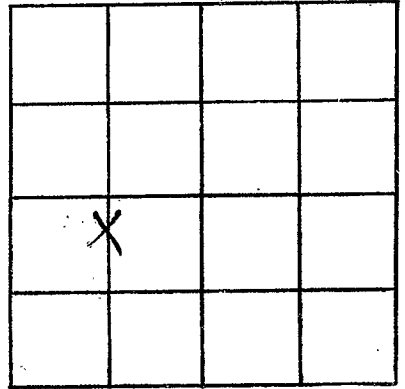

SECTION 11

Please indicate well location X.

ADDITIONAL INFORMATION

If more than one screen,
show locations of each on sketch.