

WAYNE
Z 56
3-14-74

MISSISSIPPI
 BOARD OF WATER COMMISSIONERS
 416 North State Street
 Jackson, Mississippi 39201

CODED

WATER WELL DRILLERS LOG

3-14 1974 CARRS well service Wayne
 date well completed firm name county well located

LANDOWNER	description of formations encountered	from	to
<u>W. J. CARR</u>	<u>Top soil</u>	<u>0</u>	<u>1</u>
<u>BUCATUNNA MISS</u>	<u>Red sandy clay</u>	<u>1</u>	<u>7</u>
	<u>COARSE SAND w/ GRAVEL</u>	<u>7</u>	<u>29</u>
(mailing address)	<u>white clay</u>	<u>20</u>	<u>30</u>

WELL LOCATION:
 sec 31 T 6N R 5E
S W
1/2 miles ESE of BUC
 (distance) (direction) (nearest town)

WELL PURPOSE: HOME
 (home, irrigation, municipal, industrial)

WELL COMPLETION DATA:

(1) diameter (inches) 4" x 2"

(2) total depth (feet) 30

(3) static water level (feet) 6 ^{below} _{above} top of ground.

(4) casing PVC 25'
 (material) (depth)

(size) if telescope see back.

(5) screen 5' 25'
 (length) (depth to top)

2" PVC 8 slot
 (size) (material)

(6) pump 1/2 6
 (HP) (yield gpm)

1 Elect
 (type power)

(7) electric log No
 (yes or no)

(organization running log)

(8) how well bottom plugged B.W.V.

CODED




APR - 4 1974

DRILLERS REMARKS:

MISS. BD. OF WATER COM.

If well telescopes please sketch and show depths.

GROUND LEVEL

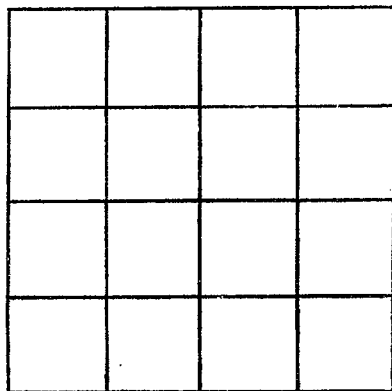

SECTION _____

Please indicate well location X.

ADDITIONAL INFORMATION

If more than one screen,
show locations of each on sketch.