

WAYNE  
 Z57  
 5-18-74

MISSISSIPPI  
 BOARD OF WATER COMMISSIONERS  
 416 North State Street  
 Jackson, Mississippi 39201

WATER WELL DRILLERS CODED

MAY 18, 1974 McILWAIN WATER WELL SERVICE WAYNE  
 date well completed RT. 2m BOX 37 county well located

WAYNESBORO, MISS. 39367

LANDOWNER:

Mrs CHARLITTA WHITE  
 STATE LINE, MISS.  
 (mailing address)

description of formations encountered

from to

Red Clay	0	8
Red Sand	8	10
Coarse White Sand	10	29

WELL LOCATION:

sec. 30 T 6 N R 5 E  
 3 miles W of STATE LINE  
 (distance) (direction) (nearest town)

WELL PURPOSE: Home  
 (home, irrigation, municipal, industrial)

WELL COMPLETION DATA:

- diameter (inches) 2"
- total depth (feet) 29'
- static water level (feet) 8' below top of ground.
- casing PVC 23' (material), (depth)  
 2" (size) if telescope see back.
- screen 6' 23' (length), (depth to top)  
 1/4" PVC .008 (size) (material)
- pump 1/2 HP 12 (yield gpm)  
 110 AC (type power)
- electric log no (yes or no)

CODED

(organization running log)


(8) how well bottom plugged

DRILLERS REMARKS:

RECEIVED  
 JUN 10 1974  
 MISS. Bd. OF WATER COMM.

If well telescopes please sketch and show depths.

GROUND LEVEL

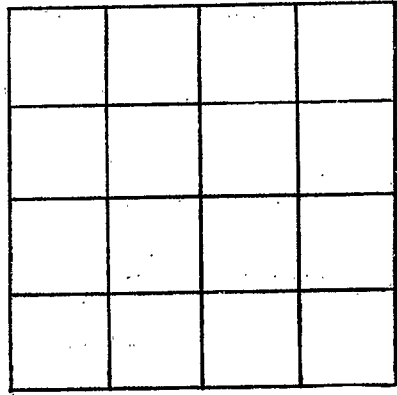

SECTION \_\_\_\_\_

Please indicate well location X.

ADDITIONAL INFORMATION

A series of horizontal lines for providing additional information, starting below the 'ADDITIONAL INFORMATION' header and extending to the bottom of the page.

If more than one screen, show locations of each on sketch.