

WAYNE
E 58
7-9-74

MISSISSIPPI
BOARD OF WATER COMMISSIONERS
416 North State Street
Jackson, Mississippi 39201

CODED

WATER WELL DRILLERS LOG

July 9 1974 date well completed
Burt O'Connell firm name
Wayne county well located

LANDOWNER: Walter Martin

description of formations encountered

from to

1207 Fairview Dr.
Waynesboro Miss
(mailing address)

WELL LOCATION:

sec. 23 T 6 N R. 5 E
S W
4 miles W of Burchett
(distance) (direction) (nearest town)

WELL PURPOSE: camp
(home, irrigation, municipal, industrial)

WELL COMPLETION DATA:

- (1) diameter (inches) 2"
- (2) total depth (feet) 250
- (3) static water level (feet) 15' ^{below} _{top of ground.}
- (4) casing steel 240'
(material) (depth)
2' if telescope see back.
(size)
- (5) screen 10' 240
(length) (depth to top)
1 1/4" bell S.S.
(size) (material)
- (6) pump none 2.5
(HP) (yield gpm)
(type power)
- (7) electric log no
(yes or no)

(organization running log)

(8) has well bottom plugged back wash valve

DRILLERS REMARKS:


description of formations encountered	from	to
sand & chalk	0	28
Chalk	28	105
sand	105	137
Chalk	137	230
sand	230	253
Chalk	253	258
Chalk & sand	258	275
sand	275	295
sand & chalk	295	290
sand	290	302
stopped on chalk		

10' 1 1/4" bell S.S.
screen screen on end
of casing with back
wash valve on end
and shell trap above

RECEIVED
SEP 11 1974

If well telescopes please sketch and show depths.

GROUND LEVEL

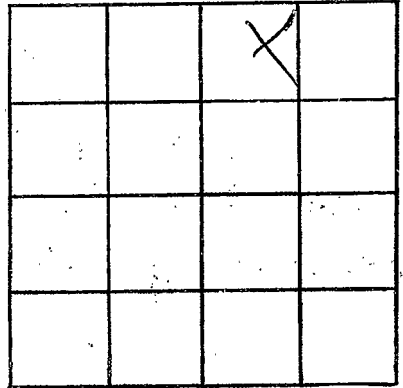

SECTION 23

Please indicate well location X.

ADDITIONAL INFORMATION

If more than one screen,
show locations of each on sketch.