

WAYNE
 E 62
 4-22-75

MISSISSIPPI
 BOARD OF WATER COMMISSIONERS
 416 North State Street
 Jackson, Mississippi 39201

CODED

WATER WELL DRILLERS LOG


April 22 1975 Port & Milling Corp Wayne
 (date well completed) (firm name) (county well located)

LANDOWNER: <u>Mellie Clark</u>	description of formations encountered	from	to
<u>Box 2 Bay 28</u> <u>State Line</u> (mailing address)			
WELL LOCATION: sec <u>22</u> T <u>60</u> N R <u>5</u> E <u>5</u> miles <u>SE</u> of <u>Buchanan</u> (distance) (direction) (nearest town)	clay	0	10
WELL PURPOSE: <u>home</u> (home, irrigation, municipal, industrial)	sand	10	12
WELL COMPLETION DATA:	clay	12	4.5
(1) diameter (inches) <u>2"</u>	clay + sand	4.5	7.5
(2) total depth (feet) <u>111'</u>	fine sand clay	7.5	89
(3) static water level (feet) <u>22'</u> (below/above top of ground)	course sand + clay	89	9.5
(4) casing <u>steel</u> <u>106'</u> (material) (depth) <u>2"</u> (size) if telescope see back.	fine sand + some clay	95	120
(5) screen <u>5'</u> <u>106'</u> (length) (depth to top) <u>1/4"</u> <u>galv. S.S.</u> (size) (material)	slight white shell sand		
(6) pump <u>1</u> <u>12</u> (HP) (yield gpm) <u>elec.</u> (type power)			
(7) electric log <u>no</u> (yes or no)			
(organization running log)			
(8) how well bottom plugged <u>back wash valve</u>			
DRILLERS REMARKS:			

REGISTERED
 MAY 8 1975

If well telescopes please sketch and show depths.

GROUND LEVEL

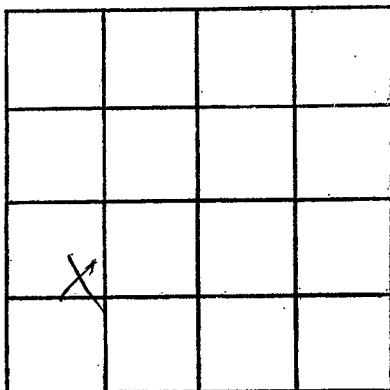

SECTION 22

Please indicate well location X.

ADDITIONAL INFORMATION

If more than one screen,
show locations of each on sketch.