

Z 63
Wayne
4/28/75

MISSISSIPPI
 BOARD OF WATER COMMISSIONERS
 416 North State Street
 Jackson, Mississippi 39201

CODED

WATER WELL DRILLERS LOG

APRIL 28 1975 Haertel's Well Service Wayne
 date well completed firm name county well located

LANDOWNER: J. B. Johnson
State Line, Miss., 39362
 (mailing address)
 WELL LOCATION:
 sec. 32 T 6 (N) R. 5 (E) S (W)
2 miles West of State Line
 (distance) (direction) (nearest town)

description of formations encountered	from	to
<u>top soil</u>	<u>0</u>	<u>1</u>
<u>red sandy clay</u>	<u>1</u>	<u>13</u>
<u>sticky red & white clay</u>	<u>13</u>	<u>31</u>
<u>clay w/ sand streaks</u>	<u>31</u>	<u>40</u>
<u>white clay</u>	<u>40</u>	<u>56</u>
<u>fine green sand</u>	<u>56</u>	<u>63</u>
<u>green & blue clay</u>	<u>63</u>	<u>98</u>
<u>clay w/ sand streaks</u>	<u>98</u>	<u>109</u>
<u>blue clay w/ sand streaks</u>	<u>109</u>	<u>178</u>
<u>white sand (CODED)</u>	<u>178</u>	<u>192</u>

WELL PURPOSE:
 (home, irrigation, municipal, industrial)


WELL COMPLETION DATA:
 (1) diameter (inches) 2"
 (2) total depth (feet) 189 ft.
 (3) static water level (feet) 36 ft. ^{below} top of ground.
 (4) casing P.V.C., 179 ft.
 (material) (depth)
2" if telescope see back.
 (size)
 (5) screen 10 ft., 179 ft.
 (length) (depth to top)
2", P.V.C.
 (size) (material)
 (6) pump 1 hp, 8 gpm
 (HP) (yield gpm)
electric
 (type power)
 (7) electric log No
 (yes or no)
 (organization running log)
 (8) how well bottom plugged Back - wash valve

DRILLERS REMARKS:

MAY 27 1975
 MISSISSIPPI BOARD OF WATER COMMISSIONERS

If well telescopes please sketch and show depths.

GROUND LEVEL

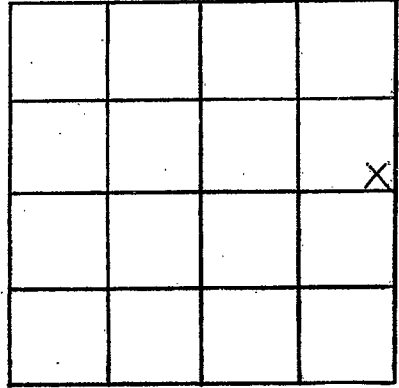

SECTION 32

Please indicate well location X.

ADDITIONAL INFORMATION

If more than one screen,
show locations of each on sketch.