

CODED

Wayne
Z Lot
5-9-75

MISSISSIPPI
BOARD OF WATER COMMISSIONERS
416 North State Street
Jackson, Mississippi 39201

WATER WELL DRILLERS LOG

May 9 1975 date well completed
Porto Drilling Co. firm name
Wayne county well located

LANDOWNER: John Clark
at 1 km 239 A
State Line Miss
(mailing address)

WELL LOCATION:
sec 27 T 6 N R 5 E 13P
1/2 miles N of State Line
(distance) (direction) (nearest town)

WELL PURPOSE: Home
(home, irrigation, municipal, industrial)


WELL COMPLETION DATA:
(1) diameter (inches) 2
(2) total depth (feet) 599
(3) static water level (feet) 54 below top of ground.
(4) casing steel 588 (material) (depth)
2' If telescope see back. (size)
(5) screen 10' 588 (length) (depth to top)
1/2" 7.5 lb SS (size) (material)
(6) pump 1 15 (HP) (yield gpm)
elec (type power)
(7) electric log no (yes or no)
(organization running log)

description of formations encountered	from	to
weat clay	0	10
blue clay	10	132
sand	132	146
blue clay	146	172
sand	172	180
clay	180	201
sand	201	225
clay	225	230
sand & clay	230	240
clay	240	270
sand & clay	270	285
clay	285	295
sand	295	325
clay & sand	325	335
clay	335	337
sand & some clay	337	353
clay	353	370
sand	370	396
sand & clay	396	397
course sand	397	400
clay & sand	400	413
with	413	414
blue clay	414	454
with	454	457
white clay & shell	457	471
with shuffler	471	498
white clay & lime	498	540
red sand	540	540
hard sand	540	548
clay & hard sand	548	555
weat blue sand	555	570
weat blue sand	570	588
weat coarse sand	588	598
clay	598	599

(8) how well bottom plugged
DRILLERS REMARKS:
10' 1/2" 7.5 lb SS screen
we get 1 of our rock back
work with on sand & shell
2' above 6 3/4" 1/2" clay
type 1' 1/2" ball pipe
lost sand of screen

If well telescopes please sketch and show depths.

GROUND LEVEL

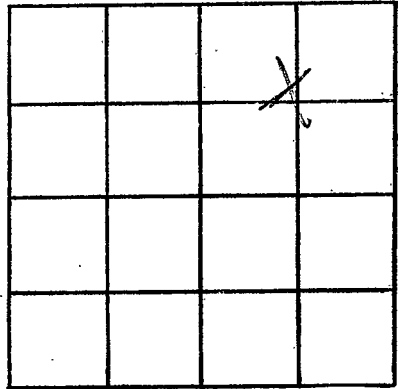

SECTION 27

Please indicate well location X.

ADDITIONAL INFORMATION

If more than one screen, show locations of each on sketch.