

CODED

Wayne
Z 65
7-3-75

MISSISSIPPI
BOARD OF WATER COMMISSIONERS
416 North State Street
Jackson, Mississippi 39201

WATER WELL DRILLERS LOG

July 3 1975 Porter Drilling Wayne
date well completed firm name county well located

| LANDOWNER: Edgno Gran Taylor At 2 State Line Miss (mailing address) | description of formations encountered | from | to |
|--|---------------------------------------|------|-----|
| | red clay + sand | 0 | 15 |
| | clay | 15 | 86 |
| | clay + sand | 86 | 101 |
| | shl. clay | 101 | 117 |
| | small to med course sand | 117 | 123 |
| | hard clay | 123 | 124 |

WELL LOCATION:

sec 22 T. 60 N. R. 5 E. 13P
2 miles N State Line
(distance) (direction) (nearest town)

WELL PURPOSE: home
(home, irrigation, municipal, industrial)

WELL COMPLETION DATA:

- (1) diameter (inches) 2"
- (2) total depth (feet) 124
- (3) static water level (feet) 20 (below top of ground)
- (4) casing P.V.C. 118' (material) (depth)
- 2" If telescope see back. (size)
- (5) screen 5' 118' (length) (depth to top)
- 1/4" bolt SS. (size) (material)
- (6) pump 1 10 (HP) (yield gpm)
- elec. (type power)
- (7) electric log (yes or no)

5' 1/4" below SS.
screwed on end of
cas with back mesh
valve on end of 1'
1/4" tail pipe
42' 1" P.V.C. drop
pipe

(organization running log)


(8) how well bottom plugged
Back wash valve

DRILLERS REMARKS:

MISSISSIPPI
BOARD OF WATER COMMISSIONERS
JUL 11 1975
MISS. Bd. of Water Comm.

If well telescopes please sketch and show depths.

GROUND LEVEL

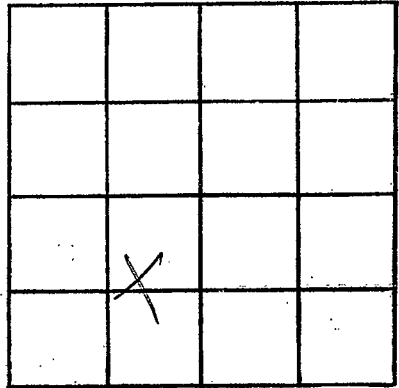

SECTION 22

Please indicate well location X.

ADDITIONAL INFORMATION

If more than one screen,
show locations of each on sketch.