

Wayne  
Z 67  
8-5-75

MISSISSIPPI  
 BOARD OF WATER COMMISSIONERS  
 416 North State Street  
 Jackson, Mississippi 39201

WATER WELL DRILLERS LOG

Aug 5 1975 Port Drilling & Log Wayne  
 date well completed firm name county well located

LANDOWNER: Lewis  
Thouillard  
at 1 State Line  
 (mailing address)

WELL LOCATION:  
 sec 8 T 6 (N) R 5 E 13P  
3 miles (distance) S (direction) of Buckatun (nearest town)

WELL PURPOSE: home  
 (home, irrigation, municipal, industrial)

WELL COMPLETION DATA:  
 (1) diameter (inches) 2"  
 (2) total depth (feet) 43  
 (3) static water level (feet) 12 (below/above top of ground)  
 (4) casing P.V.C 38' (material) (depth)  
2" (size) If telescope see back.  
 (5) screen 5' 38' (length) (depth to top)  
1/4" 6 slot SS (size) (material)  
 (6) pump 3/4 15 (HP) (yield gpm)  
elec (type power)  
 (7) electric log (yes or no) \_\_\_\_\_  
 (organization running log) \_\_\_\_\_  
 (8) how well bottom plugged back wash valve


description of formations encountered	from	to
<u>clay &amp; sand</u>	<u>0</u>	<u>15</u>
<u>sand</u>	<u>15</u>	<u>43</u>
<u>stagnant water</u>		
<u>shell in sand</u>		
<u>renewal on end of cas</u>		
<u>well back wash valve</u>		
<u>on end</u>		
<u>22' 1" P.V.C pipe</u>		
<u>pipe</u>		
<u>1/2</u>		
<u>31</u>		

MISSISSIPPI  
 BOARD OF WATER COMMISSIONERS  
 AUG 20 1975  
 MISS. Bd. OF WATER COMMISSIONERS

DRILLERS REMARKS: \_\_\_\_\_

If well telescopes please sketch and show depths.

GROUND LEVEL

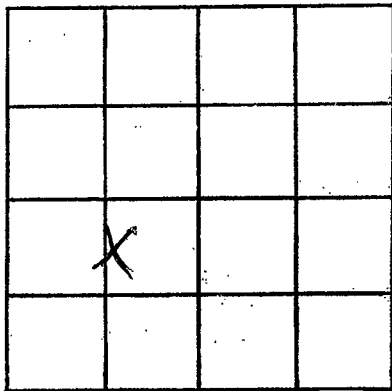

SECTION 8

Please indicate well location X.

ADDITIONAL INFORMATION

If more than one screen, show locations of each on sketch.