

Wayne
 7680
 8-27-75

MISSISSIPPI
 BOARD OF WATER COMMISSIONERS CODED
 416 North State Street
 Jackson, Mississippi 39201

WATER WELL DRILLERS LOG

Aug 27 1975 Porter Drilling Wayne
 date well completed firm name county well located

LANDOWNER: Buckatuna
Elem School
Buckatuna Miss.
 (mailing address)


description of formations encountered	from	to
red clay	0	8
sand & clay	8	20
clay	20	131
med sand	131	135
coarse sand	135	151
stagnant water		
stagnant sand		

WELL LOCATION:
 sec. 5 T. 6 N. R. 5 E. 13P
1 miles SE of Buckatuna
 (distance) (direction) (nearest town)

WELL PURPOSE: school
 (home, irrigation, municipal, industrial)

WELL COMPLETION DATA:
 (1) diameter (inches) 2"
 (2) total depth (feet) 151'
 (3) static water level (feet) 8' below above top of ground.
 (4) casing P.V.C. 146'
 (material) (depth)
2" If telescope see back. (size)
 (5) screen 5' 146'
 (length) (depth to top)
1 1/2" 6 slot SS
 (size) (material)
 (6) pump 1 20
 (HP) (yield gpm)
elec 30 gal flow
 (type power)
 (7) electric log no
 (yes or no)
 (organization running log)
 (8) how well bottom plugged from work valve

5' 1 1/2" 6 slot SS.
reverted on end of cas.
work back work
work on end & stop
top above

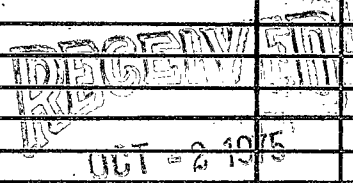


DRILLERS REMARKS:

MISS. BD. OF WATER COMMISSIONERS

If well telescopes please sketch and show depths.

GROUND LEVEL

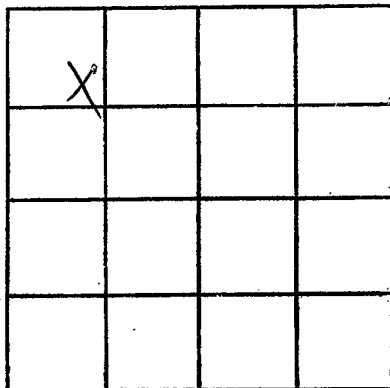

SECTION 5

Please indicate well location X.

ADDITIONAL INFORMATION

If more than one screen,
show locations of each on sketch.